

# Registration Statement

## OF CLAIMANT OF RIGHT TO APPROPRIATE GROUND WATER

TO THE STATE ENGINEER OF OREGON:

I, Maxwell W. Mitchell  
of Rt 2 Box 103 Canby County of Clack  
State of Ore, do hereby make application for a certificate of registration as evidence  
of a right to appropriate ground water.

1. Source from which water is withdrawn is pump well  
(Flowing well, sump well, infiltration trench, or tunnel)

2. Location is: five miles south of Canby Ore  
(Approximate distance and direction from nearest city or town)

and is more particularly described as follows:

(a) well located in the NE corner of NE 1/4 & SW 1/4 of 21  
(Give distance and bearing to corner of section or other legal subdivision)  
being within AE Scoble D.L.C. 71 of Sec. 21, Twp. 4S Rge. 1E  
(Smallest legal subdivision) (N. or S.) (E. or W.)

or (b) within limits of recorded platted property, town or city:

in Lot \_\_\_\_\_, Block \_\_\_\_\_ of \_\_\_\_\_  
(Name of plat or addition)  
County of Clack  
(If within city or town, give name)

3. Construction Work was begun on about 1938; was completed on 1938  
(Date) (Date)

*This well was  
bore when I  
purchased the  
land in 1942*

and the ground water claimed was first used for the purposes set out below on 1945  
(Date)

since which time the water has been used intermittently  
(Continuously or intermittently)

from 1945 to 1958  
(Date) (Date)

4. Quantity of water claimed and used is 180 gallons per minute; information available acre  
feet per year. (N.O.T. A.V.A.I.L.A.B.L.E)

5. Purpose or Purposes for which water is used irrigation

(Domestic, irrigation, municipal, manufacturing, industrial, etc.)

6. Description of Well: Depth 40 feet. Type drilled  
(Dug or drilled)

diameter 6 inches. Elevation of ground at well site 700 feet, mean sea level.  
(As near as known)

Depth to water table 12 feet.

7. Capacity of Well: \_\_\_\_\_ g.p.m. with \_\_\_\_\_ feet drawdown.

*Not available*  
\_\_\_\_\_ g.p.m. with \_\_\_\_\_ feet drawdown.

Date of test \_\_\_\_\_

If Flowing Well: Measured discharge \_\_\_\_\_ g.p.m. on \_\_\_\_\_  
(Date)

Shut-in pressure at ground surface \_\_\_\_\_ lbs. per sq. in. on \_\_\_\_\_  
(Date)

Water is controlled by \_\_\_\_\_  
(Cap. valve, etc.)

8. Casing: (Give diameter, commercial specifications and depth below ground surface of each casing size.)

6 inch diameter ..... from 1 to 40 feet  
..... inch diameter ..... from ..... to ..... feet  
..... inch diameter ..... from ..... to ..... feet  
..... inch diameter ..... from ..... to ..... feet

Describe and show depth of shoe, plug, adapter, liner or other details: .....

9. Perforated Casings or Screens:

(Number per foot and size of perforations, or describe screen) from ..... to .....  
..... from ..... to .....  
*no* ..... from ..... to .....  
..... from ..... to .....

10. Log of Well: (Describe each stratum or formation clearly, indicate if water bearing, and give thickness and depth as indicated.)

MATERIAL	Thickness (Feet)	Depth to Bottom (Feet)
.....	.....	.....
.....	.....	.....
*not known*

If log of well is not available, give name and address of driller. not known

owner is dead from whom I purchased the form

11. Infiltration Trench: Covered or open \_\_\_\_\_  
Dimensions: Length \_\_\_\_\_ ft. Minimum depth \_\_\_\_\_ ft. Maximum depth \_\_\_\_\_ ft.  
Bottom width \_\_\_\_\_ ft. Discharge \_\_\_\_\_ g.p.m. Date of test \_\_\_\_\_

12. Tunnel: Type of lining \_\_\_\_\_  
Dimensions: \_\_\_\_\_  
(Length, course, and cross sectional size)  
Position of water bearing stratum with reference to portal of tunnel \_\_\_\_\_

Log of tunnel: (Preceding table for log of well may be used, if desired. Give footage from portal and character of materials, as pertinent.)

13. Pumping Equipment:  
(a) Pump Dwight #4030 Centrifugal with 10 3/16" discharge Capacity 2 x million g.p.m.  
(b) Motor 7 1/2 HP Single Phase Electric Motor


14. Location of area irrigated or to be irrigated, or place of use if for purposes other than irrigation.

Township North or South	Range E. or W. of Willamette Meridian	Section	Forty-acre Tract	Number Acres To Be Irrigated	Date of Reclamation
4S	1E	21	NE 1/4 of SW 1/4	20 <sup>00</sup> Ac	1945

15. If the ground water supply is supplemental to an existing water supply, identification of any application for a permit, permit, certificate or adjudicated right to appropriate water made or held by the registrant.

I have a Certificate of Water right under permit 16096 to use the waters of Scubble Creek of which the waters dry up in midsummer

Township 4S Range 1E W.M.  
North

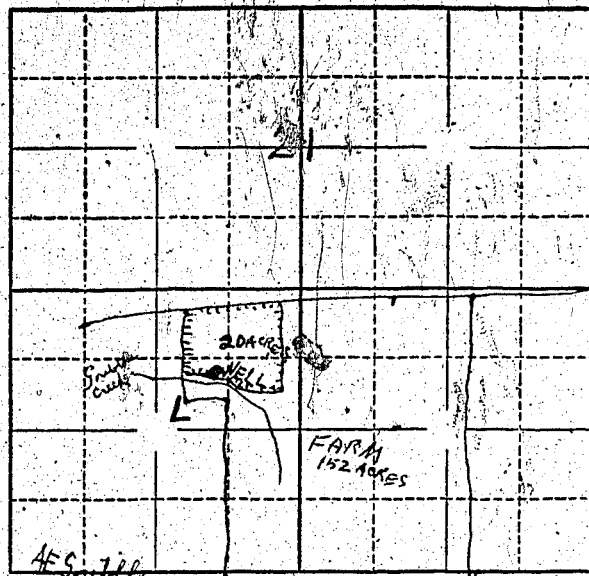

DLC41 Locate well and acreage of irrigated land on plat.  
Scale: 2" = 1 Mile

STATE OF OREGON

County of Clackamas } ss.

I, Maxwell W. Mitchell, being first duly sworn, do hereby certify that I have read the foregoing Registration Statement and that all of the items therein contained are true to the best of my knowledge and belief.

Maxwell W. Mitchell  
(Signature of Registrant)

Subscribed and sworn to before me this 10th day of July, 19 58

My commission expires June 9, 1963

M. A. Winton  
(Notary Public)

(SEAL)

**CERTIFICATE OF REGISTRATION**

STATE OF OREGON }  
County of Marion } ss.

This is to certify that the foregoing Registration Statement was received in the office of the State Engineer on the 11th day of July, 1958, at 8:00 o'clock A. M. and has been duly recorded in said office in Book No. 9 of Registration Statements on page GR-1993

Witness my hand this 9th day of February, 19 59

Laura A. Stanley  
(State Engineer)

By \_\_\_\_\_  
(Deputy)

\$15.00