

Registration Statement

OF CLAIMANT OF RIGHT TO APPROPRIATE GROUND WATER

TO THE STATE ENGINEER OF OREGON:

I, John F. Peterson
 of Rt. 1 Box 18 Turner, Oregon County of Marion
(Mailing address)
 State of Oregon, do hereby make application for a certificate of registration as evidence
 of a right to appropriate ground water.

1. Source from which water is withdrawn is Pump Well
(Flowing well, pump well, infiltration trench, or tunnel)

2. Location is: 2 1/2 Miles South-East of Turner, Oregon
(Approximate distance and direction from nearest city or town)

and is more particularly described as follows:

(a) 946 feet North and 224 feet East of the South-east Corner of Sec. 34 T. 8 S. R. 2W.
(Give distance and bearing to corner of section or other legal subdivision)
 being within South West 1/4 of S.W. 1/4 of Sec. 34, Twp. 8 S., Rge. 2 W.
(Smallest legal subdivision) (N. or S.) (E. or W.)

or (b) within limits of recorded platted property, town or city:

in Lot _____, Block _____ of _____
(Name of plat or addition)

County of _____
(If within city or town, give name)

3. Construction Work was begun on 15 June 1953; was completed on 1 July 1953
(Date) (Date)

and the ground water claimed was first used for the purposes set out below on 1 Aug. 1953
(Date)

since which time the water has been used Continuously
(Continuously or intermittently)

from 1 Aug. 1953 to Date
(Date) (Date)

4. Quantity of water claimed and used is 112.5 gallons per minute; 40 acre
 feet per year.

5. Purpose or Purposes for which water is used Irrigation

(Domestic, irrigation, municipal, manufacturing, industrial, etc.)

6. Description of Well: Depth 33 feet. Type Drilled
(Dug or drilled)
 diameter 8" inches. Elevation of ground at well site 200 feet, mean sea level.
(As near as known)
 Depth to water table 6' feet.

7. Capacity of Well: 112.5 g.p.m. with 10 feet drawdown. Does Not know
g.p.m. with feet drawdown. Exact figures but
 Date of test about 1 July 1953 believes this is
 essentially correct

If Flowing Well: Measured discharge _____ g.p.m. on _____
(Date)

Shut-in pressure at ground surface _____ lbs. per sq. in. on _____
(Date)

Water is controlled by _____
(Cap, valve, etc.)

size.)

8" inch diameter from 0 to 33 feet

Describe and show depth of shoe, plug, adapter, liner or other details:

9. Perforated Casings or Screens:

12 3/8 x 6" from 21 to 33

10. Log of Well: (Describe each stratum or formation clearly, indicate if water bearing, and give thick-

[illegible]

East Wall Drilling 4120 Market St. Salem, Oregon

Bottom width ft. Discharge g.p.m. Date of test

(Length, course, and cross sectional size)

Position of water bearing stratum with reference to portal of tunnel


(Make, type and size)

(Type and horsepower)

[illegible]

GR. 1995

Township 8S Range 2W W.M.
North

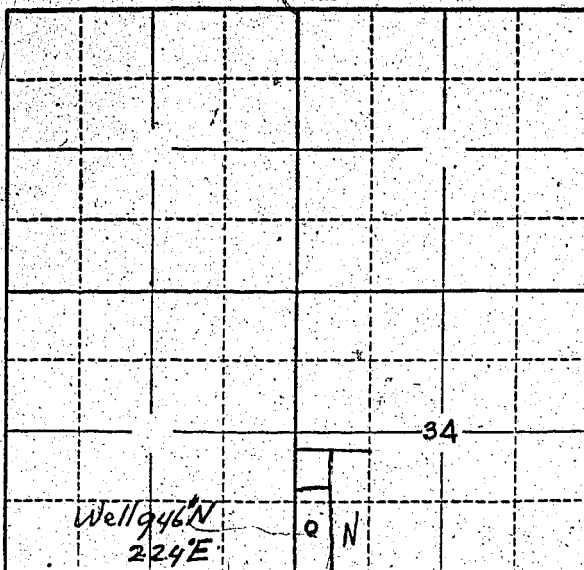

Locate well and acreage of irrigated land on plat.

Scale: 2" = 1 Mile

STATE OF OREGON

County of Marion

ss.

I, John S. Peterson, being first duly sworn, do hereby certify that I have read the foregoing Registration Statement and that all of the items therein contained are true to the best of my knowledge and belief.

Subscribed and sworn to before me this 3rd day of July, 1958

My commission expires

(SEAL)

John S. Peterson
(Signature of Registrant)

J. A. Seiler
(Notary Public)

CERTIFICATE OF REGISTRATION

STATE OF OREGON

County of Marion

ss.

This is to certify that the foregoing Registration Statement was received in the office of the State Engineer on the 11th day of July, 1958, at 2:30 o'clock P. M. and has been duly recorded in said office in Book No. 9 of Registration Statements on page GR-1995

Witness my hand this 9th day of February, 1959

\$15.00

Lewis A. Stanley
(State Engineer)

By

(Deputy)

GR - 1995