

Registration Statement

REGISTRATION NO. GR-208

CERTIFICATE NO. GR-193

OF CLAIMANT OF RIGHT TO APPROPRIATE GROUND WATER

(Under Chapter 708, Oregon Laws 1955.)

Site # 1

TO THE STATE ENGINEER OF OREGON:

I, Leland W Wells
of Jefferson County of Marion
State of Oregon

do hereby make application for a certificate of registration as evidence of a right to appropriate ground water.

1. Source from which water is withdrawn is Pump Well #1
(Flowing well, pump well, infiltration trench, or tunnel)

2. Location is: 1 MI So East of Jefferson
(Approximate distance and direction from nearest city or town)

and is more particularly described as follows:

(a) 600 feet east and 400 feet south from N 1/4 corner Section 13
(Give distance and bearing to corner of section or other legal subdivision)

being within NW 1/4 of NE 1/4 of Sec. 13, Twp. 10 S, Rge. 3 W
(Smallest legal subdivision) (N. or S.) (E. or W.)

or (b) within limits of recorded platted property, town or city:

in Lot _____, Block _____ of _____
(Name of plat or addition)

County of _____
(If within city or town, give name)

3. Construction Work was begun on May 12, 1947 was completed on May 16, 1947
(Date) (Date)

and the ground water claimed was first used for the purposes set out below on June 1947
(Date)

since which time the water has been used Continuously
(Continuously or intermittently)

from June 1947 to July 18, 1956
(Date) (Date)

4. Quantity of water claimed and used is 240 gallons per minute; _____ acre feet per year.

5. Purpose or Purposes for which water is used

Irrigation
(Domestic, irrigation, municipal, manufacturing, industrial, etc.)

6. Description of Well: Depth 20 feet. Type Drilled
(Dug or drilled)

diameter 8 inches. Elevation of ground at well site 260 feet, mean sea level.
(As near as known)

Depth to water table 10 feet.

7. Capacity of Well: _____ g.p.m. with _____ feet drawdown.

_____ g.p.m. with _____ feet drawdown.

Date of test No test


If Flowing Well: Measured discharge _____ g.p.m. on _____
(Date)

Shut-in pressure at ground surface _____ lbs. per sq. in. on _____
(Date)

Water is controlled by _____
(Cap, valve, etc.)

See Inclosed Map.

Township 10S Range 3W, W.M. North

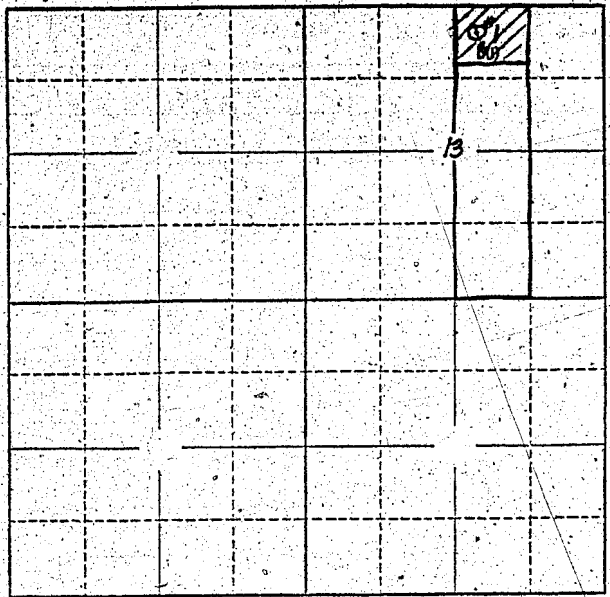

Locate well and acreage of irrigated land on plat. Scale: 2" = 1 Mile

STATE OF OREGON

County of _____ } SS.

I, _____, being first duly sworn, do hereby certify that I have read the foregoing Registration Statement and that all of the items therein contained are true to the best of my knowledge and belief.

(Signature of Registrant)

Subscribed and sworn to before me this _____ day of _____, 19____

My commission expires _____ (Notary Public)

(SEAL)

FOR CERTIFICATE SEE PAGE GR-193 G
CERTIFICATE OF REGISTRATION

STATE OF OREGON

County of Marion } SS.

This is to certify that the foregoing Registration Statement was read and filed in the office of the State Engineer on the _____ day of _____, 19____ and has been duly recorded in said office in Book No. _____ of Registration Statements on page _____.

Construction shall be completed by _____, 19____ and the water completely applied to beneficial use by _____.

Witness my hand this _____ day of _____, 19____

(State Engineer)

By _____ (Deputy)

GR-193 C

Registration Statement

REGISTRATION NO. GR-208CERTIFICATE NO. GR-193

OF CLAIMANT OF RIGHT TO APPROPRIATE GROUND WATER

(Under Chapter 708, Oregon Laws 1955.)

Site # 2

TO THE STATE ENGINEER OF OREGON:

I, Leland W Wells
 of Jefferson County of Marion
 State of Oregon, do hereby make application for a certificate of registration as evidence of a right to appropriate ground water.

1. Source from which water is withdrawn is Pump Well #2
(Flowing well, pump well, infiltration trench, or tunnel)

2. Location is: 1 1/2 mi So East of Jefferson
(Approximate distance and direction from nearest city or town)

and is more particularly described as follows:

(a) 900 feet south and 500 feet east from center of section 13
(Give distance and bearing to corner of section or other legal subdivision)

being within NW 1/4 of SE 1/4 of Sec. 13, Twp. 10S Rge. 3W
(Smallest legal subdivision) (N. or S.) (E. or W.)

or (b) within limits of recorded platted property, town or city: _____

in Lot _____, Block _____ of _____
(Name of plat or addition)

County of _____
(If within city or town, give name)

3. Construction Work was begun on July 14, 1955 was completed on July 17, 1955
(Date) (Date)

and the ground water claimed was first used for the purposes set out below on July 17, 1955
(Date)

since which time the water has been used Continuously
(Continuously or intermittently)

from July 17, 1955 to Present date 7/14/56
(Date) (Date)

4. Quantity of water claimed and used is 270 gallons per minute; _____ acre foot per year.

5. Purpose or Purposes for which water is used Irrigation

(Domestic, irrigation, municipal, manufacturing, industrial, etc.)

6. Description of Well: Depth 24 feet. Type Drilled
(Dug or drilled)

diameter 8 inches. Elevation of ground at well site 260 feet, mean sea level.
(As near as known)

Depth to water table 15 feet.

7. Capacity of Well: _____ g.p.m. with _____ feet drawdown.

_____ g.p.m. with _____ feet drawdown.

Date of test no test

If Flowing Well: Measured discharge _____ g.p.m. on _____
(Date)


Shut-in pressure at ground surface _____ lbs. per sq. in. on _____
(Date)

Water is controlled by _____
(Cap, valve, etc.)

GR-193 D

See Inclosed Map

Township 105 Range 3W W.M. North

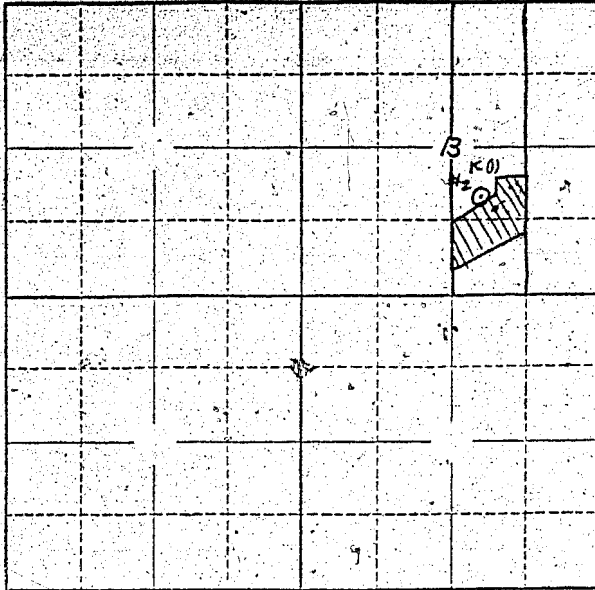

Locate well and acreage of irrigated land on plat.

Scale: 2" = 1 Mile

STATE OF OREGON

County of Marion } ss.

I, Legend W Wells, being first duly sworn, do hereby certify that I have read the foregoing Registration Statement and that all of the items therein contained are true to the best of my knowledge and belief.

Legend W Wells (Signature of Registrant)

Subscribed and sworn to before me this 18th day of July, 1956.

My commission expires September 8, 1956. (Notary Public)

(SEAL)

CERTIFICATE OF REGISTRATION

STATE OF OREGON

County of Marion } ss.

This is to certify that the foregoing Registration Statement was received in the office of the State Engineer on the 18th day of July, 1956, at 11:30 o'clock A.M. and has been duly recorded in said office in Book No. 1 of Registration Statements on page GR-193 G.

~~Construction is to be completed by October 18, 1956 and the water completely applied to the fields by October 18, 1956.~~

Witness my hand this 8th day of October, 1956.

Lewis A. Atsaley (State Engineer)

By (Deputy)