

Registration Statement

OF CLAIMANT OF RIGHT TO APPROPRIATE GROUND WATER

TO THE STATE ENGINEER OF OREGON:

I, W. A. Byers
of Rt. 1, Box 407, Salem County of Polk
(Mailing address)

State of Oregon, do hereby make application for a certificate of registration as evidence of a right to appropriate ground water.

1. Source from which water is withdrawn is Pump Well
(Flowing well, pump well, infiltration trench, or tunnel)

2. Location is: Five miles N.W. of Salem
(Approximate distance and direction from nearest city or town)

and is more particularly described as follows:

(a) 450 feet West and 350 feet South from E. corner Section 31
(Give distance and bearing to corner of section or other legal subdivision)

being within NE 1/4 of SE 1/4 of Sec. 31, Twp. 6 S, Rge. 3 W
(Smallest legal subdivision) (N. or S.) (E. or W.)

or (b) within limits of recorded platted property, town or city:

in Lot _____, Block _____ of _____
(Name of plat or addition)

County of Polk
(If within city or town, give name)

3. Construction Work was begun on May 15, 1953; was completed on May 12, 1953
(Date) (Date)

and the ground water claimed was first used for the purposes set out below on July 1953
(Date)

since which time the water has been used Intermittently
(Continuously or intermittently)

from June to Oct
(Date) (Date)

4. Quantity of water claimed and used is 192 gallons per minute; _____ acre feet per year.

5. Purpose or Purposes for which water is used _____

Irrigation
(Domestic, irrigation, municipal, manufacturing, industrial, etc.)

6. Description of Well: Depth 66 feet, Type Bored with 18" auger
(Dug or drilled)

diameter 10 inches. Elevation of ground at well site _____ feet, mean sea level.
(As near as known)

Depth to water table 10 feet.

7. Capacity of Well: 420 g.p.m. with 61 feet drawdown.

380 g.p.m. with 54 feet drawdown.


Date of test May 12, 1953

If Flowing Well: Measured discharge _____ g.p.m. on _____
(Date)

Shut-in pressure at ground surface _____ lbs. per sq. in. on _____
(Date)

Water is controlled by _____
(Cap, valve, etc.)

Township 65 Range 3W, W.M.
North

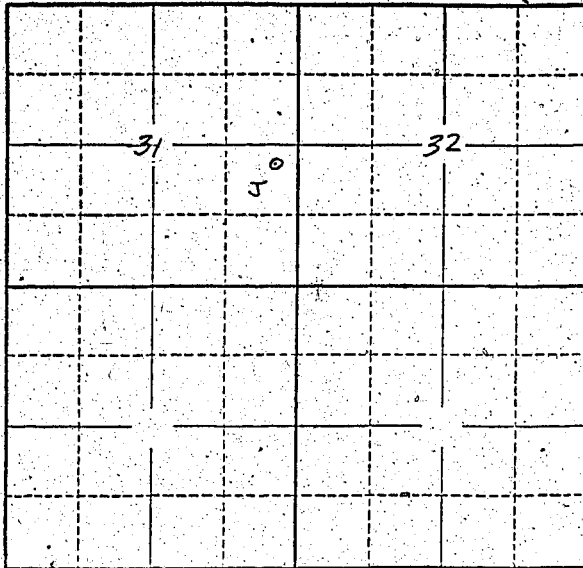

Locate well and acreage of irrigated land on plat.

Scale: 2" = 1 Mile

STATE OF OREGON

County of Marion } ss.

I, W. A. Byers, being first duly sworn, do hereby certify that I have read the foregoing Registration Statement and that all of the items therein contained are true to the best of my knowledge and belief.

W. A. Byers
(Signature of Registrant)

Subscribed and sworn to before me this 14th day of July, 19 58.

My commission expires 12th June 1961 Wm. S. Bartholomew
(Notary Public)

(SEAL)

CERTIFICATE OF REGISTRATION

STATE OF OREGON } ss.
County of Marion

This is to certify that the foregoing Registration Statement was received in the office of the State Engineer on the 14 day of July, 19 58 at 10:30 o'clock A M. and has been duly recorded in said office in Book No. 9 of Registration Statements on page GR-1999

Witness my hand this 9th day of February, 19 59

Laura A. Stanley
(State Engineer)

By _____
(Deputy)

1875

GR - 1999