

Registration Statement

OF CLAIMANT OF RIGHT TO APPROPRIATE GROUND WATER

TO THE STATE ENGINEER OF OREGON:

I, Fred L. Rose
 of 5320 N River Rd Salem County of Marion
(Mailing address)
 State of Oregon, do hereby make application for a certificate of registration as evidence
 of a right to appropriate ground water.

1. Source from which water is withdrawn is Pump Well
(Flowing well, pump well, infiltration trench, or tunnel)

2. Location is: 4 miles North of Salem
(Approximate distance and direction from nearest city or town)

and is more particularly described as follows:

(a) 1390 feet east & 1000 feet north from SW corner Section 35
(Give distance and bearing to corner of section or other legal subdivision)
 being within SE 1/4 SW 1/4 of Sec. 35, Twp. 6 S, Rge. 3 W
(Smallest legal subdivision) (N. or S.) (E. or W.)

or (b) within limits of recorded platted property, town or city:

in Lot 7, Block _____ of Claggett Fruit & Garden Tract
(Name of plat or addition)
 County of Marion
(If within city or town, give name)

3. Construction Work was begun on 1940; was completed on 1940
(Date) (Date)

and the ground water claimed was first used for the purposes set out below on July 1, 1940
(Date)

since which time the water has been used Continuously
(Continuously or intermittently)

from July 1, 1940 to July 14, 1958
(Date) (Date)

4. Quantity of water claimed and used is 50 gallons per minute; _____ acre
 feet per year.

5. Purpose or Purposes for which water is used Domestic & Irrigation
(Domestic, irrigation, municipal, manufacturing, industrial, etc.)

6. Description of Well: Depth 42 feet. Type Drilled
(Dug or drilled)

diameter 8 inches. Elevation of ground at well site _____ feet/mean sea level.
(As near as known)

Depth to water table 12 feet.

7. Capacity of Well: 50 g.p.m. with 10 feet drawdown.

_____ g.p.m. with _____ feet drawdown.

Date of test July 1940

If Flowing Well: Measured discharge _____ g.p.m. on _____
(Date)

Shut-in pressure at ground surface _____ lbs. per sq. in. on _____
(Date)

Water is controlled by _____
(Cap, valve, etc.)

8. Casing: (Give diameter, commercial specifications and depth below ground surface of each casing size.)

8 inch diameter steel casing from 2 ft above surface to 42 feet

inch diameter from to feet

inch diameter from to feet

inch diameter from to feet

Describe and show depth of shoe, plug, adapter, liner or other details:

9. Perforated Casings or Screens:

4 to the foot 1/2 x 1 inch from 34 to 42
(Number per foot and size of perforations, or describe screen)

from to

from to

from to

10. Log of Well: (Describe each stratum or formation clearly, indicate if water bearing, and give thickness and depth as indicated.)

MATERIAL	Thickness (Feet)	Depth to Bottom (Feet)
Soil	4	
Gravel	26	
Rock	10	

If log of well is not available, give name and address of driller.

11. Infiltration Trench: Covered or open None
 Dimensions: Length _____ ft. Minimum depth _____ ft. Maximum depth _____ ft.
 Bottom width _____ ft. Discharge _____ g.p.m. Date of test _____

12. Tunnel: Type of lining None
 Dimensions: _____
(Length, course, and cross sectional size)
 Position of water bearing stratum with reference to portal of tunnel _____

Log of tunnel: (Preceding table for log of well may be used, if desired. Give footage from portal and character of materials, as pertinent.)

13. Pumping Equipment:

(a) Pump Jet (Sears) Capacity 30 g.p.m.
(Make, type and size)
 (b) Motor Electric 1 HP
(Type and horsepower)


14. Location of area irrigated or to be irrigated, or place of use if for purposes other than irrigation.

Township North or South	Range E. or W. of Williamsite Meridian	Section	Forty-acre Tract	Number Acres To Be Irrigated	Date of Reclamation
6 S	3 W	35	SE 1/4 of SW 1/4	3 ⁰⁰	1940
"	"	"	SW 1/4 of SW 1/4	2 ⁰⁰	"
				5	

15. If the ground water supply is supplemental to an existing water supply, identification of any application for a permit, permit, certificate or adjudicated right to appropriate water made or held by the registrant.

Dec 35

Township 6 S Range 3 W, W.M.
North

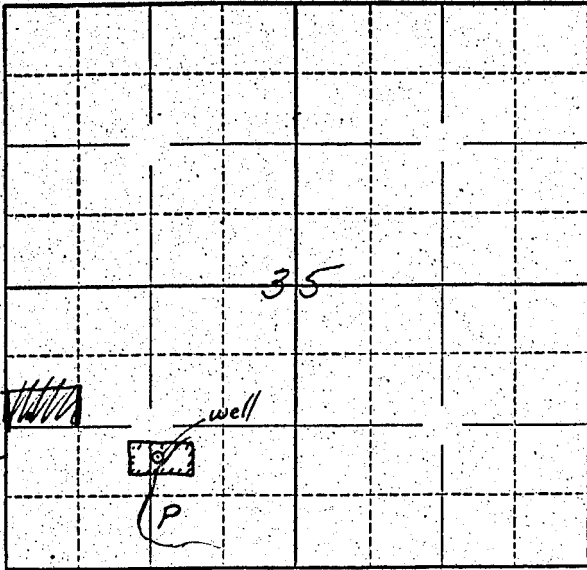

Lot 7
Claggett Tract
& Garden Tract
123 ft N of SE Corner
165 ft E of above

Locate well and acreage of irrigated land on plat.
Scale: 2" = 1 Mile

STATE OF OREGON }
County of Marion } ss.

I, Fred L. Rose, being first duly sworn, do hereby certify that I have read the foregoing Registration Statement and that all of the items therein contained are true to the best of my knowledge and belief.

Fred L. Rose
(Signature of Registrant)

Subscribed and sworn to before me this 14th day of July, 1958

My commission expires 12th June 1961 Wm. S. Bartholomew
(Notary Public)

(SEAL)

CERTIFICATE OF REGISTRATION

STATE OF OREGON }
County of Marion } ss.

This is to certify that the foregoing Registration Statement was received in the office of the State Engineer on the 14th day of July, 1958, at 11:45 o'clock A. M. and has been duly recorded in said office in Book No. 9 of Registration Statements on page GR-2000

Witness my hand this 9th day of February, 1959

Lewis A. Stanley
(State Engineer)

\$1500

By _____
(Deputy)

GR - 2000