

# Registration Statement

## OF CLAIMANT OF RIGHT TO APPROPRIATE GROUND WATER

TO THE STATE ENGINEER OF OREGON:

I, Hollie F. Swingle

of Rt. 2, Box 210 Central Point County of Jackson

State of Oregon, do hereby make application for a certificate of registration as evidence of a right to appropriate ground water.

1. Source from which water is withdrawn is pump well  
(Flowing well, pump well, infiltration,泉, or tunnel)

2. Location is: 3 1/2 mi. N.E. from Central Point, 6 mi. N. of Madford  
(Approximate distance and direction from nearest city or town)

and is more particularly described as follows: 450 feet west & 600 feet south from N 1/4 corner of Sect. 25

(a) 700 ft. S.W. of N 1/4 corner Sect. 25  
(Give distance and bearing to corner of section or other legal subdivision)

being within 40 acres NE 1/4 of NW 1/4 of Sec. 25, Twp. 36 S, Rge. 2 W  
(Smallest legal subdivision) (N-S or E-W) (E- or W.)

or (b) within limits of recorded platted property, town or city:

in Lot \_\_\_\_\_, Block \_\_\_\_\_ of \_\_\_\_\_  
(Name of plat or addition)

County of \_\_\_\_\_  
(If within city or town, give name)

3. Construction Work was begun on Oct. 5 1951; was completed on Oct. 30 1951  
(Date) (Date)

and the ground water claimed was first used for the purposes set out below on May 25, 1952  
(Date)

since which time the water has been used intermittently  
(Continuously or Intermittently)

from April 15th. to Oct. 15th.  
(Date) (Date)

4. Quantity of water claimed and used is 100 gallons per minute; \_\_\_\_\_ acre feet per year.

5. Purpose or Purposes for which water is used \_\_\_\_\_

irrigation.

(Domestic, irrigation, municipal, manufacturing, industrial, etc.)

6. Description of Well: Depth 102 feet. Type drilled  
(Dug or drilled)

diameter 8 inches. Elevation of ground at well site 1250 feet, mean sea level.  
(As near as known)

Depth to water table 15 feet.

7. Capacity of Well: \_\_\_\_\_ g.p.m. with 80 feet drawdown.

\_\_\_\_\_ g.p.m. with \_\_\_\_\_ feet drawdown.

Date of test Oct. 20 1951

If Flowing Well: Measured discharge \_\_\_\_\_ g.p.m. on \_\_\_\_\_  
(Date)


Shut-in pressure at ground surface \_\_\_\_\_ lbs. per sq. in. on \_\_\_\_\_  
(Date)

Water is controlled by \_\_\_\_\_  
(Cap, valve, etc.)





Township 36 S Range 2 W, W.M.  
North

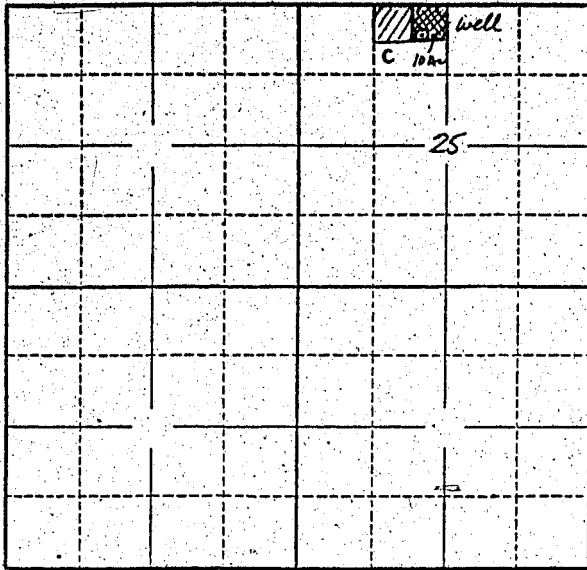

approx. 8 acres

Locate well and acreage of irrigated land on plat.

Scale: 2" = 1 Mile

STATE OF OREGON

County of Jackson } ss.

I, Hollie F. Swingle, being first duly sworn, do hereby certify that I have read the foregoing Registration Statement and that all of the items therein contained are true to the best of my knowledge and belief.

Hollie F. Swingle  
(Signature of Registrant)

Subscribed and sworn to before me this 14th day of July, 1958

My commission expires 12th June 1961 Wm. S. Bartholomew  
(Notary Public)

(SEAL)

**CERTIFICATE OF REGISTRATION**

STATE OF OREGON

County of Marion } ss.

This is to certify that the foregoing Registration Statement was received in the office of the State Engineer on the 14th day of July, 1958, at 9<sup>00</sup> o'clock A. M. and has been duly recorded in said office in Book No. 9 of Registration Statements on page GR-2001

Witness my hand this 9th day of February, 1959

Lewis A. Stanley  
(State Engineer)

By \_\_\_\_\_  
(Deputy)

\$15.00

GR-2001