RECEIVED
NOV 20 1957
STATE ENGINEER
SALEM, OREGON

Registration No. GR 2285

Certificate No. GR 2003

Registration Statement

OF CLAIMANT OF RIGHT TO APPROPRIATE GROUND WATER

TO THE STATE ENGINEER OF OREGON:

I, Bart Flanagan,

of Route 2, Junction City (Mailing address) County of Lane

State of Oregon, do hereby make application for a certificate of registration as evidence of a right to appropriate ground water.

1. **Source** from which water is withdrawn is Pump Well (Flowing well, pump well, infiltration trench, or tunnel)

2. **Location** is: 5½ Miles South of Junction City (Approximate distance and direction from nearest city or town);

and is more particularly described as follows:

(a) 778' West and 46' North of the SE corner of the SE¼ of the NE¼ of Sec 29 (Give distance and bearing to corner of section or other legal subdivision)

being within SE¼ of the NE¼ (Smallest legal subdivision) of Sec. 29, Twp. 16 S (N. or S.), Rge. 4 W (E. or W.)

or (b) within limits of recorded platted property, town or city:

in Lot ....., Block ..... of ..... (Name of plat or addition)

..... (If within city or town, give name) County of .....

3. **Construction Work** was begun on May 10, 1937 (Date); was completed on June 1, 1937 (Date)

and the ground water claimed was first used for the purposes set out below on June 2, 1937 (Date),

since which time the water has been used Continuously (Continuously or intermittently)

from June 2, 1937 (Date) to present (Date).

4. **Quantity** of water claimed and used is 170 gallons per minute; 75 acre feet per year.

5. **Purpose or Purposes** for which water is used Irrigation of pastures

..... (Domestic, irrigation, municipal, manufacturing, industrial, etc.)

6. **Description of Well:** Depth 44 feet. Type drilled (Dug or drilled)

diameter 4 inches. Elevation of ground at well site 355 (As near as known) feet, mean sea level.

Depth to water table 13 feet.

7. **Capacity of Well:** 170 g.p.m. with 7 feet drawdown.

..... g.p.m. with ..... feet drawdown.

Date of test 1 June 1937

If Flowing Well: Measured discharge ..... g.p.m. on ..... (Date)

Shut-in pressure at ground surface ..... lbs. per sq. in. on ..... (Date)

Water is controlled by ..... (Cap, valve, etc.)

6M—4-57

8. **Casing:** (Give diameter, commercial specifications and depth below ground surface of each casing size.)

4 inch diameter from 0 to 44 feet

inch diameter from to feet

inch diameter from to feet

inch diameter from to feet

Describe and show depth of shoe, plug, adapter, liner or other details:

9. **Perforated Casings or Screens:**

3/8 on 4x4 (Number per foot and size of perforations, or describe screen) from 10 to 44

from to

from to

from to

10. **Log of Well:** (Describe each stratum or formation clearly, indicate if water bearing, and give thickness and depth as indicated.)

MATERIAL	Thickness (Feet)	Depth to Bottom (Feet)
Silty Clay loam	2½	2½
Clay	1	3½
fine sand	1½	5
silty Clay	5	10
Sand and gravel	5	15
Gravel	10	25
Clay	1½	26½
Sand + gravel	17½	44

GR 2003

If log of well is not available, give name and address of driller. .....

.....

11. **Infiltration Trench:** Covered or open .....

Dimensions: Length ..... ft. Minimum depth ..... ft. Maximum depth ..... ft.

Bottom width ..... ft. Discharge ..... g.p.m. Date of test .....

12. **Tunnel:** Type of lining .....

Dimensions: .....
(Length, course, and cross sectional size)

Position of water bearing stratum with reference to portal of tunnel .....

.....

Log of tunnel: (Preceding table for log of well may be used, if desired. Give footage from portal and character of materials, as pertinent.)

13. **Pumping Equipment:**

(a) Pump Buckley centrifugal 2½ x 2 (Make, type and size) Capacity 170 g.p.m.

(b) Motor built together 5 HP electric (Type and horsepower)

14. Location of area irrigated or to be irrigated, or place of use if for purposes other than irrigation.

Township North or South	Range E. or W. of Willamette Meridian	Section	Forty-acre Tract	Number Acres To Be Irrigated	Date of Reclamation
16S	4W	29	SE¼ of the NE¼	29°	1937

15. If the ground water supply is supplemental to an existing water supply, identification of any application for a permit, permit, certificate or adjudicated right to appropriate water made or held by the registrant.

.....

.....

GR 2003

Township 16S Range 4W, W.M.

North

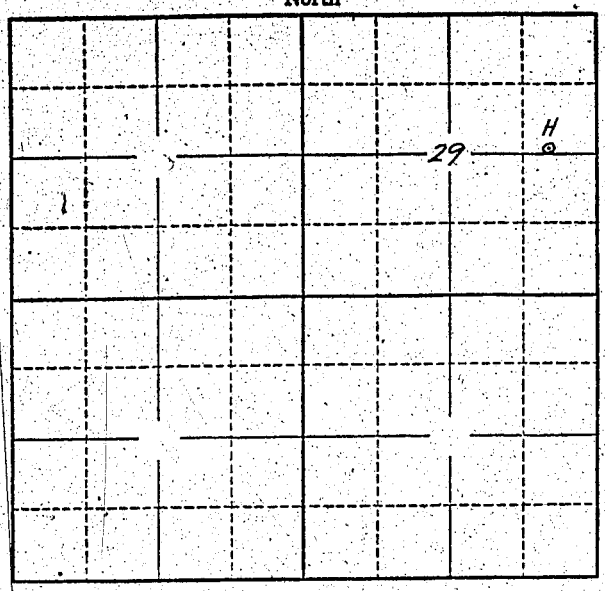

Locate well and acreage of irrigated land on plat.

Scale: 2" — 1 Mile

STATE OF OREGON
County of Lane } ss.

I, Bart Donegan, being first duly sworn, do hereby certify that I have read the foregoing Registration Statement and that all of the items therein contained are true to the best of my knowledge and belief.

Bart Donegan
(Signature of Registrant)

Subscribed and sworn to before me this 19th day of June, 1957

NOTARY PUBLIC FOR OREGON
My Commission Expires Nov. 4, 1960

My commission expires D S Dixon
(Notary Public)

(SEAL)

CERTIFICATE OF REGISTRATION

STATE OF OREGON
County of Marion } ss.

This is to certify that the foregoing Registration Statement was received in the office of the State Engineer on the 14 day of July, 1958, at 1:45 o'clock P M. and has been duly recorded in said office in Book No. 9 of Registration Statements on page GR-2003

Witness my hand this 9th day of February 1959

Lewis A. Stanley
(State Engineer)

$15.00

By
(Deputy)

GR-2003