

# Registration Statement

## OF CLAIMANT OF RIGHT TO APPROPRIATE GROUND WATER

TO THE STATE ENGINEER OF OREGON:

I, Clem Dryden  
of Route #1, Box 83 Woodburn County of Marion  
(Mailing address)

State of Oregon, do hereby make application for a certificate of registration as evidence of a right to appropriate ground water.

1. Source from which water is withdrawn is Pump Well  
(Flowing well, pump well, infiltration trench, or tunnel)

2. Location is: 2 1/2 Miles N.E. of Woodburn  
(Approximate distance and direction from nearest city or town)

and is more particularly described as follows:

(a) Apprx. 2226 ft. NW from SE Corner Section 4  
(Give distance and bearing to corner of section or other legal subdivision)

being within Condy Gardens Lot 11 of Sec. 04, Twp. 5S, Rge. 1W  
(Smallest legal subdivision) (N. or S.) (E. or W.)

or (b) within limits of recorded platted property, town or city:

in Lot \_\_\_\_\_, Block \_\_\_\_\_ of \_\_\_\_\_  
(Name of plat or addition)

County of \_\_\_\_\_  
(If within city or town, give name)

3. Construction Work was begun on Sept 1955; was completed on Sept 1955  
(Date) (Date)

and the ground water claimed was first used for the purposes set out below on Oct. 1955  
(Date)

since which time the water has been used Continuously for Domestic, Intermittently for Irrigation  
(Continuously or Intermittently)

from Oct 1955 to July 1958  
(Date) (Date)

4. Quantity of water claimed and used is 60 gallons per minute; \_\_\_\_\_ acre feet per year.

5. Purpose or Purposes for which water is used Domestic and Irrigation  
(Domestic, irrigation, municipal, manufacturing, industrial, etc.)

6. Description of Well: Depth 137 feet. Type Drilled  
(Dug or drilled)

diameter 6 inches. Elevation of ground at well site UNKNOWN feet, mean sea level.  
(As near as known)

Depth to water table 29 feet.

7. Capacity of Well: 140 g.p.m. with 36 feet drawdown.  
\_\_\_\_\_ g.p.m. with \_\_\_\_\_ feet drawdown.

Date of test Sept 1955

If Flowing Well: Measured discharge \_\_\_\_\_ g.p.m. on \_\_\_\_\_  
(Date)


Shut-in pressure at ground surface \_\_\_\_\_ lbs. per sq. in. on \_\_\_\_\_  
(Date)

Water is controlled by \_\_\_\_\_  
(Cap, valve, etc.)





Township 5S Range 14W W.M.  
North

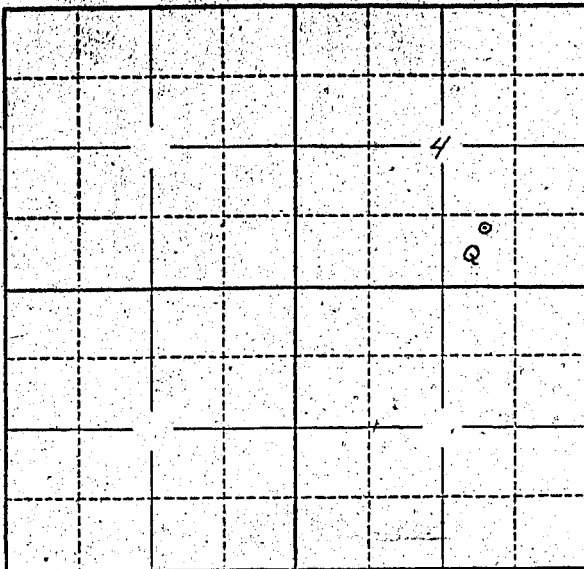

Locate well and acreage of irrigated land on plat.  
Scale: 2" = 1 Mile

STATE OF OREGON  
County of Marion

} ss.

I, CLEM DRYDEN, being first duly sworn, do hereby certify that I have read the foregoing Registration Statement and that all of the items therein contained are true to the best of my knowledge and belief.

*Clem Dryden*  
.....  
(Signature of Registrant)

Subscribed and sworn to before me this 12th day of July, 1958

My commission expires March 21, 1959

.....  
(Notary Public)

(SEAL)

**CERTIFICATE OF REGISTRATION**

STATE OF OREGON  
County of Marion

} ss.

This is to certify that the foregoing Registration Statement was received in the office of the State Engineer on the 14th day of July, 1958, at 2:30 o'clock P.M. and has been duly recorded in said office in Book No. 9 of Registration Statements on page GR 2004

Witness my hand this 9th day of February, 1959

*Russ A. Stanley*  
.....  
(State Engineer)

By .....

(Deputy)

#15.00

GR - 2004