

# Registration Statement

## OF CLAIMANT OF RIGHT TO APPROPRIATE GROUND WATER

TO THE STATE ENGINEER OF OREGON:

I, Oregon Fairview Home

of 2250 Strong Road County of Marion

(Mailing address)

State of Oregon, do hereby make application for a certificate of registration as evidence of a right to appropriate ground water.

1. Source from which water is withdrawn is Pump well #1

(Flowing well, pump well, infiltration trench, or tunnel)

2. Location is: Oregon Fairview Home 3 1/2 miles south of Salem

(Approximate distance and direction from nearest city or town)

and is more particularly described as follows:

(a) Well is 2200 ft. West & 600 ft. North of S. E. corner of Sec. 2, Twp. 8 S. Rge. 3 W. in Boiler Room.

(Give distance and bearing to corner of section or other legal subdivision)

being within N. E. 1/4 of S. E. 1/4 of Sec. 2, Twp. 8 S., Rge. 3 W.

(Smallest legal subdivision)

(N. or S.)

(E. or W.)

or (b) within limits of recorded platted property, town or city: \_\_\_\_\_

in Lot \_\_\_\_\_, Block \_\_\_\_\_ of \_\_\_\_\_

(Name of plat or addition)

County of Marion

(If within city or town, give name)

3. Construction Work was begun on 1922, was completed on 1923

(Date)

(Date)

and the ground water claimed was first used for the purposes set out below on 1923

(Date)

since which time the water has been used Continuously

(Continuously or intermittently)

from 1923 to Oct. 1957

(Date)

(Date)

4. Quantity of water claimed and used is 280 gallons per minute; \_\_\_\_\_ acre feet per year.

5. Purpose or Purposes for which water is used Domestic and irrigation

(Domestic, irrigation, municipal, manufacturing, industrial, etc.)

6. Description of Well: Depth 312 feet. Type Drilled

(Dug or drilled)

diameter 12 inches. Elevation of ground at well site 220.0 feet, mean sea level.

(As near as known)

Depth to water table 45 feet.

7. Capacity of Well: 280 g.p.m. with 70 feet drawdown. 6 hour test.

320 g.p.m. with 130 feet drawdown. Broke suction. Refer to

Date of test June 20, 1957

well report of 6/26/57 by Duffield Bros. Well #6457.

If Flowing Well: Measured discharge \_\_\_\_\_ g.p.m. on \_\_\_\_\_

(Date)

Shut-in pressure at ground surface \_\_\_\_\_ lbs. per sq. in. on \_\_\_\_\_

(Date)


Water is controlled by \_\_\_\_\_

(Cap, Valve, etc.)





Township 8 S. Range 3 W. W.M.  
North

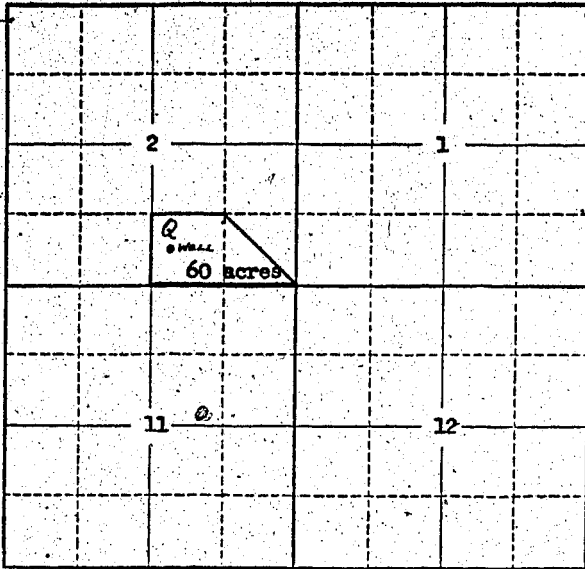

Locate well and acreage of irrigated land on plat.  
Scale: 2" = 1 Mile

STATE OF OREGON

County of Marion } ss.

I, Irvin B. Hill, being first duly sworn, do hereby certify that I have read the foregoing Registration Statement and that all of the items therein contained are true to the best of my knowledge and belief.

For Oregon Fairview Home  
By: Irvin B. Hill Supt.  
(Signature of Registrant)

Subscribed and sworn to before me this 10<sup>th</sup> day of July, 1958

My commission expires Dec. 16, 1960  
Paul F. Smith  
(Notary Public)

(SEAL)

CERTIFICATE OF REGISTRATION

STATE OF OREGON } ss.  
County of Marion

This is to certify that the foregoing Registration Statement was received in the office of the State Engineer on the 14th day of July, 1958, at 3:00 o'clock P. M. and has been duly recorded in said office in Book No. 9 of Registration Statements on page GR-2005

Witness my hand this 9<sup>th</sup> day of February, 1959

Lewis A. Stanley  
(State Engineer)

By \_\_\_\_\_ (Deputy)

\$ 29.50

GR-2005