

Registration Statement

OF CLAIMANT OF RIGHT TO APPROPRIATE GROUND WATER

TO THE STATE ENGINEER OF OREGON:

I, Rudolph John Fenk
of Star Route West Box 21 Tillamook County of Tillamook
(Mailing address)

State of Oregon, do hereby make application for a certificate of registration as evidence of a right to appropriate ground water.

1. Source from which water is withdrawn is pump well
(Flowing well, pump well, infiltration trench, or tunnel)

2. Location is: about 1 mile west and north of Tillamook, ORE
(Approximate distance and direction from nearest city or town)

and is more particularly described as follows:

(a) 950 ft South and 2000 ft West of NE corner of Sec. 26
(Give distance and bearing to corner of section or other legal subdivision)

being within NW 1/4 of NE 1/4 of Sec. 26, Twp. 15, Rge. 10 W
(Smallest legal subdivision) (N. or S.) (E. or W.)

or (b) within limits of recorded platted property, town or city:

in Lot _____, Block _____ of _____
(Name of plat or addition)

(If within city or town, give name) County of Tillamook

3. Construction Work was begun on _____; was completed on 11-25-1952
(Date) (Date)

and the ground water claimed was first used for the purposes set out below on June 1, 1953
(Date)

since which time the water has been used Continuously
(Continuously or Intermittently)

from 1953 to Oct 1957
(Date) (Date)

4. Quantity of water claimed and used is 172 gallons per minute; 75 acre feet per year.

5. Purpose or Purposes for which water is used Irrigation & domestic

(Domestic, irrigation, municipal, manufacturing, industrial, etc.)

6. Description of Well: Depth 76 feet. Type drilled
(Dug or drilled)

diameter 8 inches. Elevation of ground at well site 73.0 (O.S.H.D.) feet, mean sea level.
(As near as known)

Depth to water table 5 feet.

7. Capacity of Well: 172 g.p.m. with 3 feet drawdown.

_____ g.p.m. with _____ feet drawdown.


Date of test _____

If Flowing Well: Measured discharge _____ g.p.m. on _____
(Date)

Shut-in pressure at ground surface _____ lbs. per sq. in. on _____
(Date)

Water is controlled by _____
(Cap, valve, etc.)

Township 1 S Range 10 W, W.M.
North

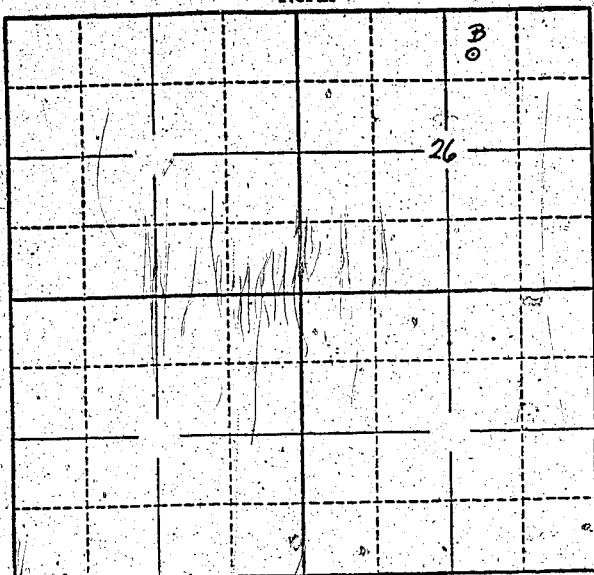

Locate well and acreage of irrigated land on plat.
Scale: 2" = 1 Mile

STATE OF OREGON

County of Willamette } ss.

I, Rudolph John Feink, being first duly sworn, do hereby certify that I have read the foregoing Registration Statement and that all of the items therein contained are true to the best of my knowledge and belief.

Rudolph John Feink
(Signature of Registrant)

Subscribed and sworn to before me this 12th day of July, 1958

My Commission Expires Oct. 17, 1960

My commission expires _____

Wm. A. Wrightson
(Notary Public)

(SEAL)

CERTIFICATE OF REGISTRATION

STATE OF OREGON

County of Marion } ss.

This is to certify that the foregoing Registration Statement was received in the office of the State Engineer on the 14 day of July, 1958, at 8:00 o'clock A. M. and has been duly recorded in said office in Book No. 9 of Registration Statements on page GR 2007

Witness my hand this 9th day of February, 1959

Laura A. Stanley
(State Engineer)

By _____ (Deputy)

\$15.00

GR - 2007