

RECEIVED  
JUL 14 1958

STATE ENGINEER  
SALEM, OREGON

RECEIVED  
JAN 18 1960

STATE ENGINEER  
SALEM, OREGON

### Registration Statement

Registration No. GR 2091

Certificate No. GR 3916

#### OF CLAIMANT OF RIGHT TO APPROPRIATE GROUND WATER

TO THE STATE ENGINEER OF OREGON:

I, Shaddens D. Shepherd  
of Thilton Freewater County of Umatilla  
(Mailing address)

State of Oregon, do hereby make application for a certificate of registration as evidence of a right to appropriate ground water.

1. Source from which water is withdrawn is Pump well  
(Flowing well, pump well, infiltration trench, or tunnel)

2. Location is: 1/4 mile Umatilla  
(Approximate distance and direction from nearest city or town)

and is more particularly described as follows: 175 feet west of 170 feet South from E 1/4 corner

(a) S - 24 rods of 10 ft. of Sec. 25 8 Dec 20 1913  
(Give distance and bearing to corner of section or other legal subdivision)

being within NE 1/4 of SE 1/4 of Sec. 25, Twp. 6 N, Rge. 34 E  
(Smallest legal subdivision) (S. or N.) (E. or W.)

or (b) within limits of recorded platted property, town or city:

in Lot \_\_\_\_\_, Block \_\_\_\_\_ of \_\_\_\_\_  
(Name of plat or addition)

County of \_\_\_\_\_  
(If within city or town, give name)

3. Construction Work was begun on 1913, was completed on 1913  
(Date) (Date)

and the ground water claimed was first used for the purposes set out below on prior to 1913  
(Date)

since which time the water has been used intermittently  
(Continuously or intermittently)

from May to Aug  
(Date) (Date)

4. Quantity of water claimed and used is 200 gallons per minute; \_\_\_\_\_ acre  
feet per year.

5. Purpose or Purposes for which water is used irrigation  
(Domestic, irrigation, municipal, manufacturing, industrial, etc.)

6. Description of Well: Depth 70 feet; Type aug 28 ft then drilled  
(Dug or drilled)  
diameter 16 inches. Elevation of ground at well site 9623.5 feet, mean sea level.  
(As near as known)

Depth to water table 26 feet.

7. Capacity of Well: \_\_\_\_\_ g.p.m. with \_\_\_\_\_ feet drawdown.  
\_\_\_\_\_ g.p.m. with \_\_\_\_\_ feet drawdown.

Date of test 1944

If Flowing Well: Measured discharge \_\_\_\_\_ g.p.m. on \_\_\_\_\_  
(Date)

Shut-in pressure at ground surface \_\_\_\_\_ lbs. per sq. in. on \_\_\_\_\_  
(Date)


Water is controlled by \_\_\_\_\_  
(Cap, valve, etc.)

*pumps dry in Aug.*





Township 6N Range 34E W.M.  
North

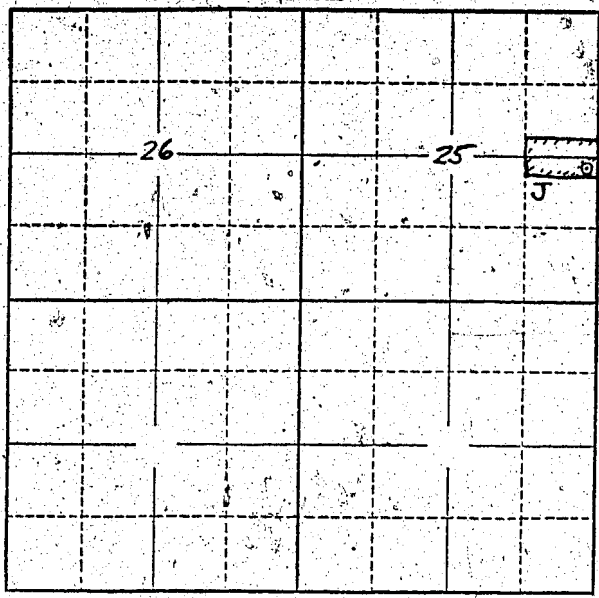

Locate well and acreage of irrigated land on plat.  
Scale: 2" = 1 Mile

STATE OF OREGON }  

I, Thad Shepherd being first duly sworn, do hereby certify that I have read the foregoing Registration Statement and that all of the items therein contained are true to the best of my knowledge and belief.

Thad Shepherd  
(Signature of Registrant)

Subscribed and sworn to before me this 11th day of July, 1958

My commission expires Feb 3, 1962  
John A. Kusk  
(Notary Public)

(SEAL)

**CERTIFICATE OF REGISTRATION**

STATE OF OREGON }  
County of Marion } ss.

This is to certify that the foregoing Registration Statement was received in the office of the State Engineer on the 14 day of July, 1958, at 8:00 o'clock A. M. and has been duly recorded in said office in Book No. 16 of Registration Statements on page OR 3916

Witness my hand this 15th day of February, 1960

Lewis A. Stanley  
(State Engineer)

By \_\_\_\_\_  
(Deputy)

GR. 3916

15.00