

RECEIVED  
JUL 14 1958  
STATE ENGINEER  
SALEM, OREGON

Registration No. GR. 2092  
Certificate No. GR. 2009

### Registration Statement

#### OF CLAIMANT OF RIGHT TO APPROPRIATE GROUND WATER

TO THE STATE ENGINEER OF OREGON:

I, B.F. ROSS  
of Harrisburg Oregon Rt 1 County of Lane  
(Mailing Address)

State of O do hereby make application for a certificate of registration as evidence of a right to appropriate ground water.

- 1. Source from which water is withdrawn is Pump Well  
(Flowing well, pump well, infiltration trench, or tunnel)
- 2. Location is: 1 mile west Harrisburg  
(Approximate distance and direction from nearest city or town)

and is more particularly described as follows:

(a) 1175' S. & 400' W. of N.E. Cor. Sec. 17  
(Give distance and bearing to corner of section or other legal subdivision)

being within \_\_\_\_\_ of Sec. 17 Twp. 15 S Rge. 4-4  
(Smallest legal subdivision) (N. or S.) (E. or W.)

or (b) within limits of recorded platted property, town or city:

in Lot \_\_\_\_\_ Block \_\_\_\_\_ of \_\_\_\_\_  
(Name of plat or addition)

County of Lane  
(If within city or town, give name)

3. Construction Work was begun on 1950; was completed on 1950  
(Date) (Date)

and the ground water claimed was first used for the purposes set out below on 1950  
(Date)

since which time the water has been used Intermittently  
(Continuously or intermittently)

from 1950 to Present  
(Date) (Date)

4. Quantity of water claimed and used is 150 gallons per minute; 70 acre feet per year.

5. Purpose or Purposes for which water is used Irrigation  
(Domestic, irrigation, municipal, manufacturing, industrial, etc.)

6. Description of Well: Depth 20 feet. Type Driven  
(Dug or drilled)

diameter 4 inches. Elevation of ground at well site 310 feet, mean sea level.  
(As near as known)

Depth to water table 10 feet.

7. Capacity of Well: 250 g.p.m. with 2 feet drawdown.  
\_\_\_\_\_ g.p.m. with \_\_\_\_\_ feet drawdown.

Date of test \_\_\_\_\_

If Flowing Well: Measured discharge \_\_\_\_\_ g.p.m. on \_\_\_\_\_  
(Date)


Shut-in pressure at ground surface \_\_\_\_\_ lbs. per sq. in. on \_\_\_\_\_  
(Date)

Water is controlled by \_\_\_\_\_  
(Cap, valve, etc.)





Township 155 Range 4W, W.M.  
North

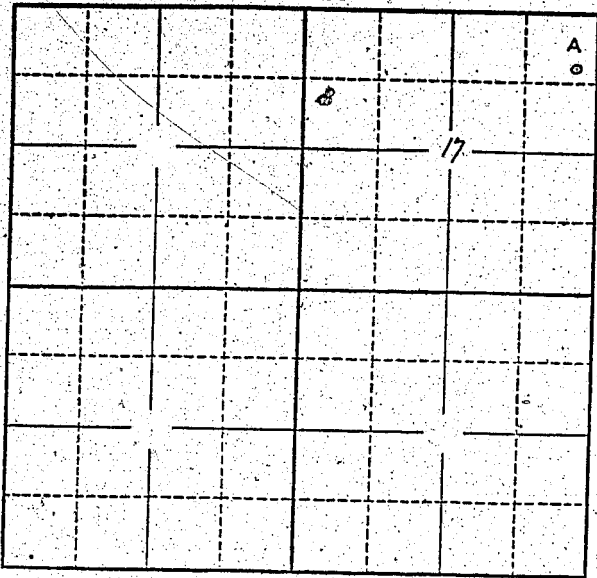

Locate well and acreage of irrigated land on plat.  
Scale: 2" = 1 Mile

STATE OF OREGON

County of Linn } ss.

I, B. F. Ross, being first duly sworn, do hereby certify that I have read the foregoing Registration Statement and that all of the items therein contained are true to the best of my knowledge and belief.

B. F. Ross

(Signature of Registrant)

Subscribed and sworn to before me this 11th day of July, 19 58.

My commission expires August 13, 1958

[Signature]

(Notary Public)

(SEAL)

**CERTIFICATE OF REGISTRATION**

STATE OF OREGON

County of Marion } ss.

This is to certify that the foregoing Registration Statement was received in the office of the State Engineer on the 14 day of July, 19 58, at 8:00 o'clock A. M. and has been duly recorded in said office in Book No. 9 of Registration Statements on page GR-2009

Witness my hand this 9th day of February, 19 59

[Signature]

(State Engineer)

By \_\_\_\_\_

(Deputy)

\$15.25