

RECEIVED  
JUN 14 1958  
STATE ENGINEER  
SALEM, OREGON

Registration No. GR-2094  
Certificate No. GR-2011

# Registration Statement

## OF CLAIMANT OF RIGHT TO APPROPRIATE GROUND WATER

TO THE STATE ENGINEER OF OREGON:

I, SAM WATSON  
of 430 HUNSAKER Eugene County of LANE  
(Mailing address)  
State of OREGON, do hereby make application for a certificate of registration as evidence of a right to appropriate ground water.

1. Source from which water is withdrawn is PUMP WELL #2  
(Flowing well, pump well, infiltration trench, or tunnel)
2. Location is: 1/4 mi. E. FROM SANTA CLARA  
(Approximate distance and direction from nearest city or town)

and is more particularly described as follows:

- (a) 567° 0' E 1350' FROM W 1/4 COR SEC 12  
(Give distance and bearing to corner of section or other legal subdivision)
- being within NW 1/4 SW of Sec. 12, Twp. 17S, Rge. 4W  
(Smallest legal subdivision) (N. or S.) (E. or W.)
- or (b) within limits of recorded platted property, town or city:

in Lot \_\_\_\_\_, Block \_\_\_\_\_ of \_\_\_\_\_  
(Name of plat or addition)  
County of \_\_\_\_\_  
(If within city or town, give name)

3. Construction Work was begun on 1946; was completed on 1946  
(Date) (Date)

and the ground water claimed was first used for the purposes set out below on 1946  
(Date)

since which time the water has been used Continuously  
(Continuously or Intermittently)

from MAY to OCT  
(Date) (Date)

4. Quantity of water claimed and used is 100 gallons per minute; 4.32 acre feet per year.

5. Purpose or Purposes for which water is used \_\_\_\_\_

Irrigation  
(Domestic, irrigation, municipal, manufacturing, industrial, etc.)

6. Description of Well: Depth 21 feet. Type DRIVE  
(Dug or drilled)

diameter 4 inches. Elevation of ground at well site \_\_\_\_\_ feet; mean sea level.  
(As near as known)

Depth to water table 16 feet.

7. Capacity of Well: \_\_\_\_\_ g.p.m. with \_\_\_\_\_ feet drawdown.  
\_\_\_\_\_ g.p.m. with \_\_\_\_\_ feet drawdown.

Date of test Not tested

If Flowing Well: Measured discharge \_\_\_\_\_ g.p.m. on \_\_\_\_\_  
(Date)


Shut-in pressure at ground surface \_\_\_\_\_ lbs. per sq. in. on \_\_\_\_\_  
(Date)

Water is controlled by \_\_\_\_\_  
(Cap, valve, etc.)





Township 173 Range 4W W.M.  
North

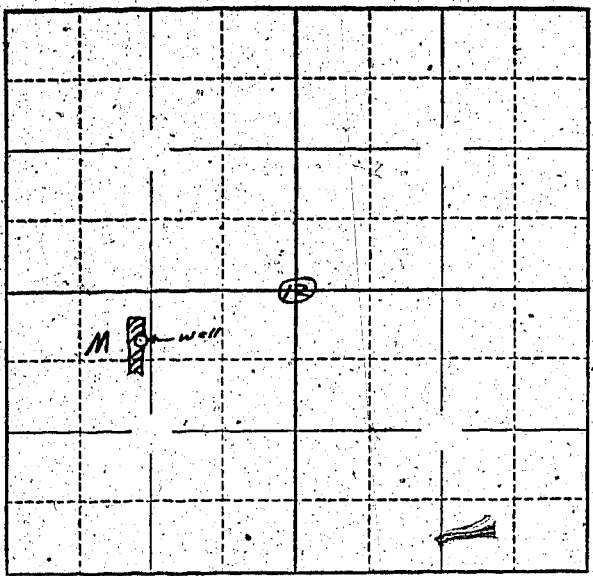

Locate well and acreage of irrigated land on plat.  
Scale: 2" = 1 Mile

STATE OF OREGON }  
County of Marion } ss.

I, \_\_\_\_\_, being first duly sworn, do hereby certify that I have read the foregoing Registration Statement and that all of the items therein contained are true to the best of my knowledge and belief.

Sam Watson  
(Signature of Registrant)

Subscribed and sworn to before me this 1st day of April, 1958

My commission expires 12th June 1961  
Wm. S. Bartholomew  
(Notary Public)

(SEAL)

**CERTIFICATE OF REGISTRATION**

STATE OF OREGON }  
County of Marion } ss.

This is to certify that the foregoing Registration Statement was received in the office of the State Engineer on the 14 day of July, 1958, at 8:00 o'clock A. M. and has been duly recorded in said office in Book No. 9 of Registration Statements on page GR-2011

Witness my hand this 9th day of February, 1959

Lewis A. Stanley  
(State Engineer)

\$1500

By \_\_\_\_\_  
(Deputy)