

RECEIVED
JUL 14 1958
STATE ENGINEER
SALEM, OREGON

Registration No. GR-2096

Certificate No. GR 2013

Registration Statement

OF CLAIMANT OF RIGHT TO APPROPRIATE GROUND WATER

TO THE STATE ENGINEER OF OREGON:

I, L. R. McKee

of Box 245, Jacksonville County of Jackson
(Mailing address)

State of Oregon, do hereby make application for a certificate of registration as evidence of a right to appropriate ground water.

1. Source from which water is withdrawn is Sump.
(Flowing well, pump well, infiltration trench, or tunnel)

2. Location is: Within city limits of Jacksonville, Ore.
(Approximate distance and direction from nearest city or town)

and is more particularly described as follows:

(a) 420 feet South and 825 feet West from the NE. corner of DLC #37
(Give distance and bearing to corner of section or other legal subdivision)

being within NW $\frac{1}{4}$ SW $\frac{1}{4}$ SE $\frac{1}{4}$ of Sec. 29, Twp. 37 S., Rge. 2 W.
(Smallest legal subdivision) (N. or S.) (E. or W.)

or (b) within limits of recorded platted property, town or city:

in Lot _____, Block _____ of _____
(Name of plat or addition)

County of _____
(If within city or town, give name)

3. Construction Work was begun on July 1955; was completed on July 1955
(Date) (Date)

and the ground water claimed was first used for the purposes set out below on August 1955
(Date)

since which time the water has been used continuously
(Continuously or Intermittently)

from August 1955 to present
(Date) (Date)

4. Quantity of water claimed and used is 60 gallons per minute; 27 acre feet per year.

5. Purpose or Purposes for which water is used Irrigation

(Domestic, irrigation, municipal, manufacturing, industrial, etc.)

6. Description of ~~well~~ sump: Depth 21 feet. Type Lug
(Dug or drilled)

diameter 30' x 50' inches. Elevation of ground at well site 1520 feet, mean sea level.
(As near as known)

Depth to water table 10 feet.

7. Capacity of Well: 60 g.p.m. with 10 feet drawdown.

_____ g.p.m. with _____ feet drawdown.

Date of test none - noted from use

If Flowing Well: Measured discharge _____ g.p.m. on _____
(Date)

Shut-in pressure at ground surface _____ lbs. per sq. in. on _____
(Date)

Water is controlled by _____
(Cap, valve, etc.)

8. Casing: (Give diameter, commercial specifications and depth below ground surface of each casing size.)

..... inch diameter none from to 11 feet
..... inch diameter from to feet
..... inch diameter from to feet
..... inch diameter from to feet

Describe and show depth of shoe, plug, adapter, liner or other details:

9. Perforated Casings or Screens:

..... none from to
(Number per foot and size of perforations, or describe screen)
..... from to
..... from to
..... from to

10. Log of Well: (Describe each stratum or formation clearly, indicate if water bearing, and give thickness and depth as indicated.)

MATERIAL	Thickness (Feet)	Depth to Bottom (Feet)
Top soil (Black clay loam)	10	11
Cement Gravel (Water bearing)	11	0

If log of well is not available, give name and address of driller. Tru Mix Concrete Co.

Medford, Oregon

11. Infiltration Trench: Covered or open open

Dimensions: Length 50 ft. Minimum depth 15 ft. Maximum depth 21 ft.

Bottom width 20 ft. Discharge g.p.m. Date of test none

12. Tunnel: Type of lining

Dimensions:
(Length, course, and cross sectional size)

Position of water bearing stratum with reference to portal of tunnel

Log of tunnel: (Preceding table for log of well may be used, if desired. Give footage from portal and character of materials, as pertinent.)

13. Pumping Equipment:

(a) Pump 1.25 inch Centrifugal pump Capacity 60 g.p.m.
(Make, type and size)

(b) Motor 1.5 H. P. electric motor
(Type and horsepower)


14. Location of area irrigated or to be irrigated, or place of use if for purposes other than irrigation.

Township North or South	Range E. or W. of Willamette Meridian	Section	Forty-acre Tract	Number Acres To Be Irrigated	Date of Reclamation
37 S.	2W.	29	SW $\frac{1}{4}$ NW $\frac{1}{4}$ SE $\frac{1}{4}$	2.6	August 1955
"	"	"	NW $\frac{1}{4}$ SW $\frac{1}{4}$ SE $\frac{1}{4}$	<u>3.4</u>	August 1955
			Total	6.0 acres	

15. If the ground water supply is supplemental to an existing water supply, identification of any application for a permit, permit, certificate or adjudicated right to appropriate water made or held by the registrant.

none

Township 37 S. Range 2. W., W.M.
North

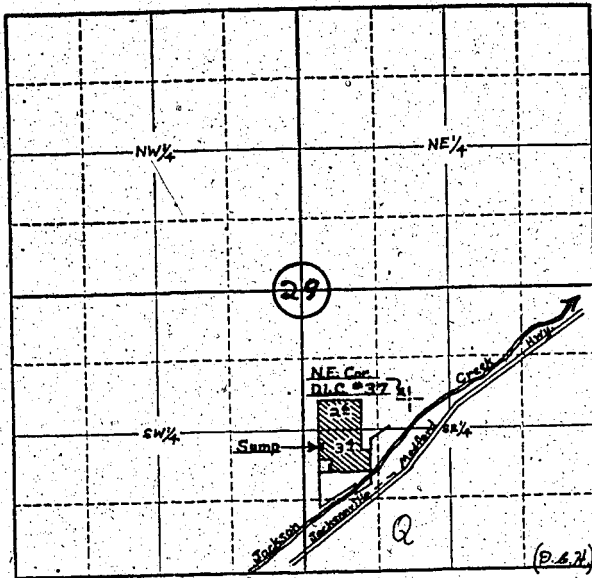

Locate well and acreage of irrigated land on plat.
Scale: 4" = 1 Mile

STATE OF OREGON

County of Jackson } ss.

I, D. R. McKee, being first duly sworn, do hereby certify that I have read the foregoing Registration Statement and that all of the items therein contained are true to the best of my knowledge and belief.

X _____
(Signature of Registrant)

Subscribed and sworn to before me this 11 day of February, 1959

My commission expires Oct 4 1959 _____
(Notary Public)

(SEAL)

CERTIFICATE OF REGISTRATION

STATE OF OREGON

County of Marion } ss.

This is to certify that the foregoing Registration Statement was received in the office of the State Engineer on the 14 day of July, 1958, at 8:00 o'clock A. M. and has been duly recorded in said office in Book No. 9 of Registration Statements on page GR-2013

Witness my hand this 9th day of February, 1959
Leura A. Stanley
(State Engineer)

By _____
(Deputy)

GR-2013

#1500