

RECEIVED
 JUL 14 1958
 STATE ENGINEER
 SALEM, OREGON

Registration No. GR-2027

Certificate No. GR-2014

Registration Statement

OF CLAIMANT OF RIGHT TO APPROPRIATE GROUND WATER

TO THE STATE ENGINEER OF OREGON:

I, Hazel Roderick
 of Rt. 2, Box 206, Central Point County of Jackson
(Mailing address)

State of Oregon, do hereby make application for a certificate of registration as evidence of a right to appropriate ground water.

1. Source from which water is withdrawn is (Sump) Infiltration trench
(Flowing well, pump well, infiltration trench, or tunnel)
2. Location is: 5 miles north of Medford, Oregon
(Approximate distance and direction from nearest city or town)

and is more particularly described as follows:

- (a) 1340 feet South and 815 feet West from the N¹ Cor. of Sec. 25
(Give distance and bearing to corner of section or other legal subdivision)
 being within N¹2 N¹2 SE¹2 NW¹2 of Sec. 25, Twp. 36 S, Rge. 2 W
(Smallest legal subdivision) (N. or S.) (E. or W.)
- or (b) within limits of recorded platted property, town or city:
 in Lot _____, Block _____ of _____
(Name of plat or addition)
 County of _____
(If within city or town, give name)

3. Construction Work was begun on 1950; was completed on 1950
(Date) (Date)

and the ground water claimed was first used for the purposes set out below on 1954
(Date)

since which time the water has been used continuously
(Continuously or Intermittently)

from 1954 to present
(Date) (Date)

4. Quantity of water claimed and used is 100 gallons per minute; 45 acre feet per year.

5. Purpose or Purposes for which water is used Irrigation

6. Description of ~~well~~ Sump (Domestic, irrigation, municipal, manufacturing, industrial, etc.)
 Depth 14 feet, Type Dug (Dug or drilled)
 diameter 10' x 12' Elevation of ground at well site 1260 feet, mean sea level.
(As near as known)
 Depth to water table 6 feet.

7. Capacity of Well: _____ g.p.m. with _____ feet drawdown.
 _____ g.p.m. with _____ feet drawdown.

Date of test _____

If Flowing Well: Measured discharge _____ g.p.m. on _____
(Date)

Shut-in pressure at ground surface _____ lbs. per sq. in. on _____
(Date)

Water is controlled by _____
(Cap, valve, etc.)

8. Casing: (Give diameter, commercial specifications and depth below ground surface of each casing size.)

..... inch diameter none from to feet
 inch diameter from to feet
 inch diameter from to feet
 inch diameter from to feet

Describe and show depth of shoe, plug, adapter, liner or other details:

9. Perforated Casings or Screens:

..... none from to
 (Number per foot and size of perforations, or describe screen)
 from to
 from to
 from to

10. Log of Well: (Describe each stratum or formation clearly, indicate if water bearing, and give thickness and depth as indicated.)

MATERIAL	Thickness (Feet)	Depth to Bottom (Feet)
<u>not known</u>		

If log of well is not available, give name and address of driller. not known

11. Infiltration Trench: Covered or open open

Dimensions: Length 12 ft. Minimum depth 12 ft. Maximum depth 14 ft.

Bottom width 10 ft. Discharge g.p.m. Date of test none

12. Tunnel: Type of lining

Dimensions:
(Length, course, and cross sectional size)

Position of water bearing stratum with reference to portal of tunnel

Log of tunnel: (Preceding table for log of well may be used, if desired. Give footage from portal and character of materials, as pertinent.)

13. Pumping Equipment:

(a) Pump 1.5 inch Centrifugal pump (Pacific) Capacity g.p.m.
(Make, type and size)

(b) Motor 3 H.P. electric motor
(Type and horsepower)


14. Location of area irrigated or to be irrigated, or place of use if for purposes other than irrigation.

Township North or South	Range E. or W. of Willamette Meridian	Section	Forty-acre Tract	Number Acres To Be Irrigated	Date of Reclamation
36 S	2 W	25	N $\frac{1}{2}$ N $\frac{1}{2}$ SE $\frac{1}{4}$ NW $\frac{1}{4}$	9.7 acres	1954

15. If the ground water supply is supplemental to an existing water supply, identification of any application for a permit, permit, certificate or adjudicated right to appropriate water made or held by the registrant.

none

Township 36 S. Range 2 W., W.M.
North

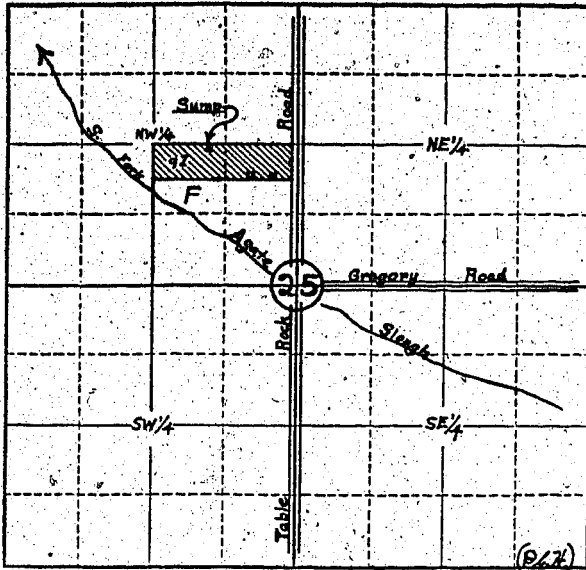

Locate well and acreage of irrigated land on plat.
Scale: 4" = 1 Mile

STATE OF OREGON


I, Harold Roderick, being first duly sworn, do hereby certify that I have read the foregoing Registration Statement and that all of the items therein contained are true to the best of my knowledge and belief.

Harold Roderick
(Signature of Registrant)

Subscribed and sworn to before me this 10th day of July, 1958

My commission expires 8/22/60
(Notary Public)

(SEAL)

CERTIFICATE OF REGISTRATION

STATE OF OREGON

County of Marion } ss.

This is to certify that the foregoing Registration Statement was received in the office of the State Engineer on the 14 day of July, 1958, at 8:00 o'clock A.M. and has been duly recorded in said office in Book No. 9 of Registration Statements on page GR 2014

Witness my hand this 9th day of February, 1959

Lewis A. Stanley
(State Engineer)

By _____ (Deputy)

GR-2014

4/500