

RECEIVED
JUL 14 1958
STATE ENGINEER
SALEM, OREGON

Registration No. GR. 2099
Certificate No. GR. 2016

Registration Statement

OF CLAIMANT OF RIGHT TO APPROPRIATE GROUND WATER

TO THE STATE ENGINEER OF OREGON:

I, Blanche L Ransom
of Rte 3 Box 327 Milton Freewater County of Umatilla
(Mailing address)

State of Oregon, do hereby make application for a certificate of registration as evidence of a right to appropriate ground water.

- 1. Source from which water is withdrawn is pump well
(Flowing well, pump well, infiltration trench, or tunnel)
- 2. Location is: 3 1/2 miles N Milton Freewater
(Approximate distance and direction from nearest city or town)

and is more particularly described as follows:

(a) 621 ft E & 30 ft N of SW cor. Sect 24
(Give distance and bearing to corner of section or other legal subdivision)
being within SW 1/4 SE 1/4 of Sec. 24, Twp. 6N, Rge. 35E
(Smallest legal subdivision) (N. or S.) (E. or W.)

or (b) within limits of recorded platted property, town or city: _____

in Lot _____, Block _____ of _____
(Name of plat or addition)

County of _____
(If within city or town, give name)

3. Construction Work was begun on Prior to 1922; was completed on Prior to 1922
(Date) (Date)

and the ground water claimed was first used for the purposes set out below on Prior to 1922
(Date)

since which time the water has been used CONTINUOUSLY
(Continuously or intermittently)
from Apr or May to Sept or Oct each year
(Date) (Date)

4. Quantity of water claimed and used is 300 gallons per minute; 76 acre feet per year.

5. Purpose or Purposes for which water is used irrigation

(Domestic, irrigation, municipal, manufacturing, industrial, etc.)

6. Description of Well: Depth 55 feet. Type 2 1/2 ft Dia - 30 ft Drilled
(Dug or drilled)

diameter Drilled 8 inches. Elevation of ground at well site 800 feet, mean sea level.
(As near as known)

Depth to water table _____ feet.

7. Capacity of Well: 430 g.p.m. with 6 feet drawdown.

_____ g.p.m. with _____ feet drawdown.

Date of test Not test

If Flowing Well: Measured discharge _____ g.p.m. on _____
(Date)

Shut-in pressure at ground surface _____ lbs. per sq. in. on _____
(Date)

Water is controlled by _____
(Cap, valve, etc.)

8. Casing: (Give diameter, commercial specifications and depth below ground surface of each casing size.)

72x72 inch diameter Cement Curbing from 0 to 15 feet

8 inch diameter Steel from 22 to 37 feet

inch diameter from to feet

inch diameter from to feet

Describe and show depth of shoe, plug, adapter, liner or other details: _____

9. Perforated Casings or Screens:

(Number per foot and size of perforations, or describe screen) _____ from _____ to _____

_____ from _____ to _____

_____ from _____ to _____

_____ from _____ to _____

10. Log of Well: (Describe each stratum or formation clearly, indicate if water bearing, and give thickness and depth as indicated.)

MATERIAL	Thickness (Feet)	Depth to Bottom (Feet)
Top Soil Gravelly + Cobble	0	15
Cement Gravel	15	55

If log of well is not available, give name and address of driller. H. N. K. N. W. D. N.

11. Infiltration Trench: Covered or open

Dimensions: Length ft. Minimum depth ft. Maximum depth ft.

Bottom width ft. Discharge g.p.m. Date of test

12. Tunnel: Type of lining

Dimensions:
(Length, course, and cross sectional size)

Position of water bearing stratum with reference to portal of tunnel

Log of tunnel: (Preceding table for log of well may be used, if desired. Give footage from portal and character of materials, as pertinent.)

13. Pumping Equipment:

(a) Pump 2" Centrifugal Pump Capacity 300 g.p.m.
(Make, type and size)

(b) Motor 1 1/2 H.P. 3 phase Electric
(Type and horsepower)

14. Location of area irrigated or to be irrigated, or place of use if for purposes other than irrigation.

Township North or South	Range E. or W. of Willamette Meridian	Section	Forty-acre Tract	Number Acres To Be Irrigated	Date of Reclamation
<u>6N</u>	<u>35E</u>	<u>24</u>	<u>5 1/2 SW 1/4 SE 1/4</u>	<u>20.0</u>	<u>1922</u>

15. If the ground water supply is supplemental to an existing water supply, identification of any application for a permit, permit, certificate or adjudicated right to appropriate water made or held by the registrant.


N.P.N.R.

SE 1/4 Section 24

Township 6N Range 35E, W.M.

North

24

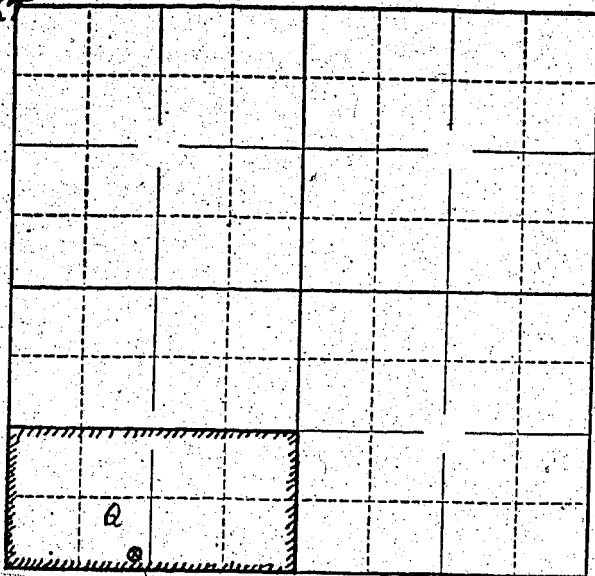

Well location
 621 ft E +
 30 ft N of
 SW cor. of
 SE 1/4 Sec 24
 T6N R35E

Locate well and acreage of irrigated land on plat.

Scale: $\frac{1}{8''}$ = 1 Mile

STATE OF OREGON

County of Umatilla } ss.

I, BLANCHE RANSOM

being first duly sworn, do hereby certify that I have read the foregoing Registration Statement and that all of the items therein contained are true to the best of my knowledge and belief.

Blanche Ransom
 (Signature of Registrant)

Subscribed and sworn to before me this 9th day of July, 1958

My commission expires May 7, 1961

Henry K... ..
 (Notary Public) for Oregon

(SEAL)

CERTIFICATE OF REGISTRATION

STATE OF OREGON

County of Marion } ss.

This is to certify that the foregoing Registration Statement was received in the office of the State Engineer on the 14 day of July, 1958, at 8.00 o'clock A. M. and has been duly recorded in said office in Book No. 9 of Registration Statements on page GR 2016

Witness my hand this 9th day of February, 1959

Levon A. Stanley
 (State Engineer)

By _____ (Deputy)

\$15.00