GR-210
GR-195

Registration Statement

OF CLAIMANT OF RIGHT TO APPROPRIATE GROUND WATER

(Under Chapter 708, Oregon Laws 1955.)

TO THE STATE ENGINEER OF OREGON:

I, Dick Rockhill,
of Yamhill Dayton Rt 1 Box 103 County of Yamhill
State of Oregon, do hereby make application for a certificate of registration as evidence of a right to appropriate ground water.

1. **Source** from which water is withdrawn is drilled well
(Flowing well, pump well, infiltration trench, or tunnel)

2. **Location** is: 7 mile south - 1 mile east of Dayton Oregon
(Approximate distance and direction from nearest city or town)

and is more particularly described as follows:

(a) 2000 ft west - 630 ft south from N.E. corner of Sec. 22
(Give distance and bearing to corner of section or other legal subdivision)

being within NW ¼ of NE ¼ of Sec. 22, Twp. 5 S (N. or S.), Rge. 3 W (E. or W.)
(Smallest legal subdivision)

or (b) within limits of recorded platted property, town or city:

in Lot ....., Block ....., of .....
(Name of plat or addition)

..... County of .....
(If within city or town, give name)

3. **Construction Work** was begun on 1939 (Date); was completed on 1939 (Date)

and the ground water claimed was first used for the purposes set out below on 1939 (Date)

since which time the water has been used Continuously during irrigation season
(Continuously or intermittently)

from 1939 (Date) to 1956 (Date)

4. **Quantity** of water claimed and used is 400 gallons per minute; 65 acre feet per year.

5. **Purpose or Purposes** for which water is used irrigation
(Domestic, irrigation, municipal, manufacturing, industrial, etc.)

6. **Description of Well:** Depth 30 feet. Type Drilled (Dug or drilled)

diameter 8 inches. Elevation of ground at well site ..... (As near as known) feet, mean sea level.

Depth to water table 15 feet. Aug.

7. **Capacity of Well:** ..... g.p.m. with ..... feet drawdown.

..... g.p.m. with ..... feet drawdown.

Date of test .....

If Flowing Well: Measured discharge ..... g.p.m. on ..... (Date)

Shut-in pressure at ground surface ..... lbs. per sq. in. on ..... (Date)

Water is controlled by ..... (Cap, valve, etc.)

8. **Casing:** (Give diameter, commercial specifications and depth below ground surface of each casing size.)

8 inch diameter Steel Casing from 0 to 30 feet

..... inch diameter ..... from ..... to ..... feet

..... inch diameter ..... from ..... to ..... feet

..... inch diameter ..... from ..... to ..... feet

Describe and show depth of shoe, plug, adapter, liner or other details: .....

9. **Perforated Casings or Screens:**

Perforated (Number per foot and size of perforations, or describe screen) from 20 to 30 ft

..... from ..... to .....

..... from ..... to .....

..... from ..... to .....

10. **Log of Well:** (Describe each stratum or formation clearly, indicate if water bearing, and give thickness and depth as indicated.)

MATERIAL	Thickness (Feet)	Depth to Bottom (Feet)
Soil	12 ft	12 ft
Sand	14 ft	26 ft
Gravel	4 ft	30 ft

GR-195 A

If log of well is not available, give name and address of driller. Huffman Drilling Co of Newberg Oregon

11. **Infiltration Trench:** Covered or open .....

Dimensions: Length ..... ft. Minimum depth ..... ft. Maximum depth ..... ft.

Bottom width ..... ft. Discharge ..... g.p.m. Date of test .....

12. **Tunnel:** Type of lining .....

Dimensions: .....
(Length, course, and cross sectional size)

Position of water bearing stratum with reference to portal of tunnel .....

Log of tunnel: (Preceding table for log of well may be used, if desired. Give footage from portal and character of materials, as pertinent.)

13. **Pumping Equipment:**

(a) Pump 20 horse built together centrifugal (Make, type and size) Capacity 400 g.p.m.

(b) Motor 20 horse electric (Type and horsepower)

14. Location of area irrigated or to be irrigated, or place of use if for purposes other than irrigation.

Township North or South	Range E. or W. of Willamette Meridian	Section	Forty-acre Tract	Number Acres To Be Irrigated	Date of Reclamation
5S	3 W	22	NW¼ of NE¼	36	1939
"	"	"	NE¼ of NE¼	26	1939
				62	

15. If the ground water supply is supplemental to an existing water supply, identification of any application for a permit, permit, certificate or adjudicated right to appropriate water made or held by the registrant.

.....

.....

GR-195B

Township 7 S Range 3 W, W.M.

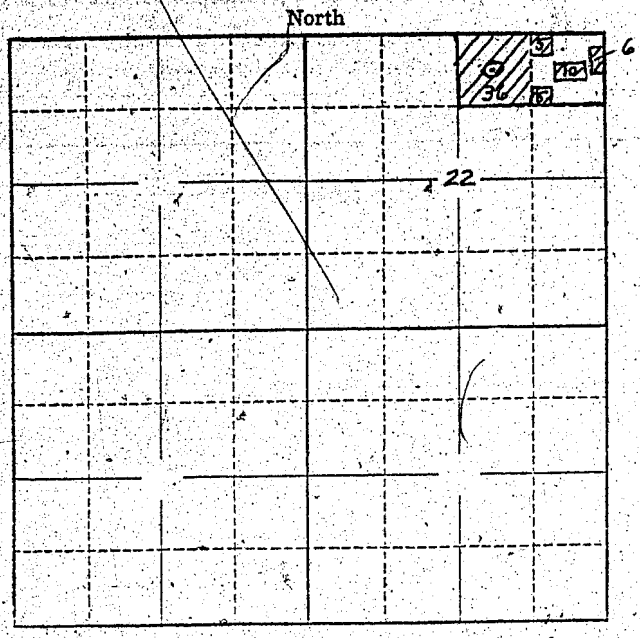

Locate well and acreage of irrigated land on plat.

Scale: 2" = 1 Mile

STATE OF OREGON
County of Marion } ss.

I, Dick Rockhill, being first duly sworn, do hereby certify that I have read the foregoing Registration Statement and that all of the items therein contained are true to the best of my knowledge and belief.

Dick Rockhill
(Signature of Registrant)

Subscribed and sworn to before me this 18th day of July, 1956.

My commission expires Sept. 8, 1956

Chas. L. Corbett
(Notary Public)

(SEAL)

CERTIFICATE OF REGISTRATION

STATE OF OREGON
County of Marion } ss.

This is to certify that the foregoing Registration Statement was received in the office of the State Engineer on the 18th day of July, 1956, at 8 o'clock A. M. and has been duly recorded in said office in Book No. 1 of Registration Statements on page GR-195 C

~~Construction shall be completed by X-X-X-X-X-X-X-X-X-19-X-X-and the water to be applied to beneficial use by X-X-X-X-X-X-X-X-X-19-X-X-~~

Witness my hand this 23rd day of November, 1956.

Lewis A. Stanley
(State Engineer)

By
(Deputy)

GR-195C