

RECEIVED
JUL 17 1958
STATE ENGINEER
ALEX. G. STON

Registration No. GR-2101
Certificate No. GR-2018

Registration Statement

OF CLAIMANT OF RIGHT TO APPROPRIATE GROUND WATER

TO THE STATE ENGINEER OF OREGON:

I, Paul S. Chambers & Pearl C. Chambers
of 2100 River Loop # 100 Eugene County of Lane
(Mailing address)

State of Oregon do hereby make application for a certificate of registration as evidence of a right to appropriate ground water.

1. Source from which water is withdrawn is Driven Well
(Flowing well, pump well, infiltration trench, or tunnel)

2. Location is: 7 1/2 Miles North of Eugene Oregon
(Approximate distance and direction from nearest city or town)

and is more particularly described as follows:

(a) 2450' W & 460' N FROM SE CORNER Sec 36
(Give distance and bearing to corner of section or other legal subdivision)

being within SW 1/4 SE of Sec. 36, Twp. 16 S, Rge. 4 W
(Smallest legal subdivision) (N. or S.) (E. or W.)

or (b) within limits of recorded platted property, town or city: _____

in Lot _____, Block _____ of _____
(Name of plat or addition)

County of _____
(If within city or town, give name)

3. Construction Work was begun on April 1, 1940 was completed on April 10, 1940
(Date) (Date)

and the ground water claimed was first used for the purposes set out below on Aug 1, 1940
(Date)

since which time the water has been used Intermittently
(Continuously or intermittently)

from Aug 1, 1940 to Sept 1, 1957
(Date) (Date)

4. Quantity of water claimed and used is 275 gallons per minute; 40 acre feet per year.

5. Purpose or Purposes for which water is used Irrigation
(Domestic, irrigation, municipal, manufacturing, industrial, etc.)

6. Description of Well: Depth 20 feet. Type Drive
(Dug or drilled)

diameter 2-3" inches. Elevation of ground at well site 300 feet, mean sea level.
(As near as known)

Depth to water table 14 feet.

7. Capacity of Well: _____ g.p.m. with _____ feet drawdown.
_____ g.p.m. with _____ feet drawdown.


Date of test MO

If Flowing Well: Measured discharge _____ g.p.m. on _____
(Date)

Shut-in pressure at ground surface _____ lbs. per sq. in. on _____
(Date)

Water is controlled by _____
(Cap. valve, etc.)

Township 16S Range 4W, W.M.
North

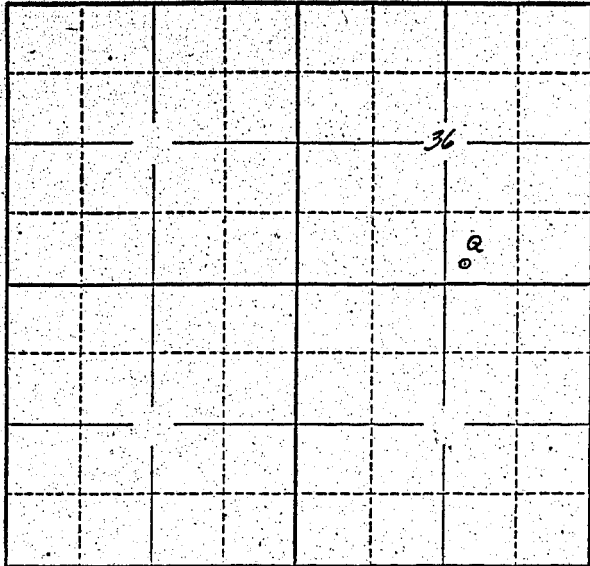

Locate well and acreage of irrigated land on plat.
Scale: 2" = 1 Mile

STATE OF OREGON

County of Lane } ss.

I, PAUL S. CHAMBERS, being first duly sworn, do hereby certify that I have read the foregoing Registration Statement and that all of the items therein contained are true to the best of my knowledge and belief.

Paul S. Chambers
(Signature of Registrant)

Subscribed and sworn to before me this 14th day of March, 1958

My commission expires June 25, 1961

Walter J. Hansen
(Notary Public)

(SEAL)

CERTIFICATE OF REGISTRATION

STATE OF OREGON

County of Marion } ss.

This is to certify that the foregoing Registration Statement was received in the office of the State Engineer on the 14th day of July, 1958, at 8:00 o'clock A. M. and has been duly recorded in said office in Book No. 9 of Registration Statements on page GR 2018

Witness my hand this 9th day of February, 1959

Lewis A. Stanley
(State Engineer)

\$15.00

By _____ (Deputy)

GR - 2018