

15
3/12/58
58
RECEIVED
JUL 14 1958
STATE ENGINEER
SALEM, OREGON

Registration No. GR. 3102
Certificate No. GR. 2019

Registration Statement

OF CLAIMANT OF RIGHT TO APPROPRIATE GROUND WATER

TO THE STATE ENGINEER OF OREGON:

I, Paul Redfearn
of Rte 3 Box 344, Milton Freewater County of Umatilla
(Mailing address)
State of Oregon, do hereby make application for a certificate of registration as evidence
of a right to appropriate ground water.

1. Source from which water is withdrawn is pump well
(Flowing well, pump well, infiltration trench, or tunnel)
2. Location is: 1 1/2 Miles North Milton Freewater Locust Road
(Approximate distance and direction from nearest city or town)

and is more particularly described as follows: 1400 ft. west & 600 ft. South from NE corner Sect. 35.
30 ft West 17 ft North of SE Corner of Property
being within NE 1/4 of NW 1/4 of NE 1/4 of Sec. 35, Twp. 6N, Rge. 35E
(Give distance and bearing to corner of section or other legal subdivision)
(Smallest legal subdivision) (N. or S.) (E. or W.)

or (b) within limits of recorded platted property, town or city: _____
in Lot _____, Block _____ of _____
(Name of plat or addition)
County of _____
(If within city or town, give name)

3. Construction Work was begun on 1923, was completed on 1924
(Date) (Date)
and the ground water claimed was first used for the purposes set out below on 1924
(Date)
since which time the water has been used practically continuously
(Continuously or intermittently)
from 1924 to 1957
(Date) (Date)


X 4. Quantity of water claimed and used is 150 gallons per minute; 60 acre
feet per year.
5. Purpose or Purposes for which water is used irrigation

(Domestic, irrigation, municipal, manufacturing, industrial, etc.)
6. Description of Well: Depth 72 feet. Type 1 1/2" 52 ft Drilled 20
5 x 6 ft dug well diameter 10 inches. Elevation of ground at well site 950 feet, mean sea level.
(Dug or drilled) (As near as known)
Depth to water table 50 1/2 feet. Mar 5, 1958 (June 1 approx 35 ft)

X 7. Capacity of Well: 150 g.p.m. with 12-15 feet drawdown.
_____ g.p.m. with _____ feet drawdown.

Date of test _____
If Flowing Well: Measured discharge _____ g.p.m. on _____ (Date)
Shut-in pressure at ground surface _____ lbs. per sq. in. on _____ (Date)
Water is controlled by _____
(Cap. valve, etc.)

Township 6 N Range 35 E W.M.
 NE 1/4 of NW 1/4 North of NE 1/4 Section 35

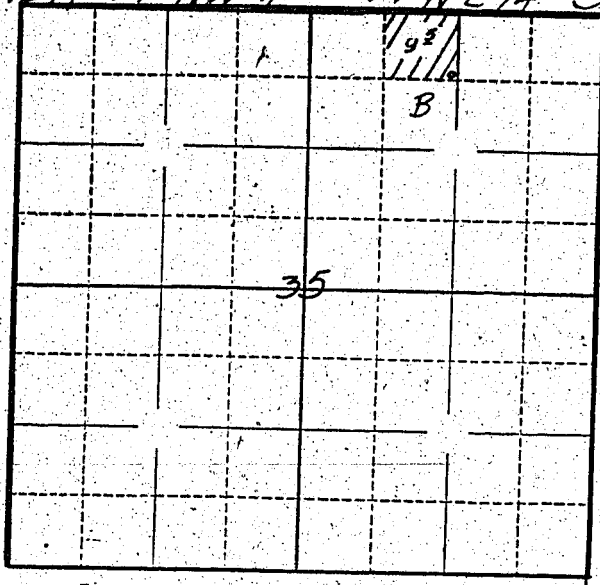

Locate well and acreage of irrigated land on plat.
 Scale: $\frac{1}{2}$ " = 1 Mile

30 ft West
 17 ft North of
 South East
 Property Corner

STATE OF OREGON

County of Umatilla } ss.

I, Paul Redfearn, being first duly sworn, do hereby certify that I have read the foregoing Registration Statement and that all of the items therein contained are true to the best of my knowledge and belief.

Paul Redfearn
 (Signature of Registrant)

Subscribed and sworn to before me this 6 day of March, 1958

My commission expires Sept 8, 1960

Cliff Hader
 (Notary Public)

(SEAL)

CERTIFICATE OF REGISTRATION

STATE OF OREGON

County of Marion } ss.

This is to certify that the foregoing Registration Statement was received in the office of the State Engineer on the 14 day of July, 1958, at 8:00 o'clock A.M. and has been duly recorded in said office in Book No. 9 of Registration Statements on page GR-2019

Witness my hand this 9th day of February, 1959

Levia A. Stanley
 (State Engineer)

By _____ (Deputy)

\$15.00

GR-2019