

STATE ENGINEER
SALEM, OREGON

Registration No. GR - 2115

Certificate No. GR - 2023

Registration Statement

OF CLAIMANT OF RIGHT TO APPROPRIATE GROUND WATER

TO THE STATE ENGINEER OF OREGON:

I, Portland Golf Club by George B. North 190
of 5900 SW Scholls Ferry Rd. County of Washington
(Mailing address)

State of Oregon do hereby make application for a certificate of registration as evidence of a right to appropriate ground water.

1. Source from which water is withdrawn is pump well # 1
(Flowing well, pump well, infiltration trench, or tunnel)

2. Location is: 1/2 mile south of Road Raleigh Hills
(Approximate distance and direction from nearest city or town)

and is more particularly described as follows:

(a) N 22° 30' E 900 feet from SW corner Section 13
(Give distance and bearing to corner of section or other legal subdivision)

being within SW 1/4 of SW 1/4 of Sec. 13 Twp. 1 S Rge. 1 W
(Small legal subdivision) (N. or S.) (E. or W.)

or (b) within limits of recorded platted property, town or city:

in Lot _____ Block _____ of _____
(Name of plat or addition)

County of _____
(If within city or town, give name)

3. Construction Work was begun on 1936; was completed on 1936
(Date) (Date)

and the ground water claimed was first used for the purposes set out below on 1936
(Date)

since which time the water has been used Continuously
(Continuously or intermittently)

from 1936 to 1958
(Date) (Date)

4. Quantity of water claimed and used is 200 gallons per minute; 25 acre feet per year.

5. Purpose or Purposes for which water is used: Irrigation

(Domestic, irrigation, municipal, manufacturing, industrial, etc.)

6. Description of Well: Depth 300 feet. Type drilled
(Dug or drilled)

diameter 12 inches. Elevation of ground at well site 200 feet, mean sea level.
(As near as known)

Depth to water table 360? feet.

7. Capacity of Well: 200 g.p.m. with 300? feet drawdown.

_____ g.p.m. with _____ feet drawdown.


Date of test never

If Flowing Well: Measured discharge _____ g.p.m. on _____
(Date)

Shut-in pressure at ground surface _____ lbs. per sq. in. on _____
(Date)

Water is controlled by _____
(Cap, valve, etc.)

Township 15 Range 10, W.M.
North

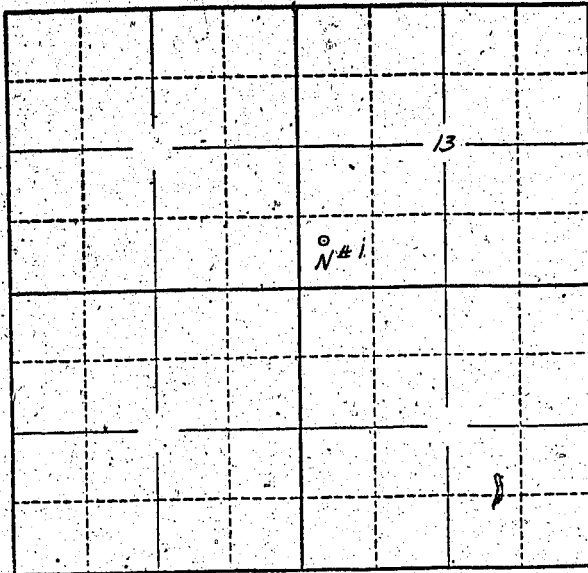

Locate well and acreage of irrigated land on plat.
Scale: 2" = 1 Mile

STATE OF OREGON }
County of Marion } ss.

I, _____, being first duly sworn, do hereby certify that I have read the foregoing Registration Statement and that all of the items therein contained are true to the best of my knowledge and belief.

Joe Edward Myers
(Signature of Registrant)

Subscribed and sworn to before me this 7th day of July, 1958

My commission expires 12th June 1961 Wm. S. Bartholomew
(Notary Public)

(SEAL)

CERTIFICATE OF REGISTRATION

STATE OF OREGON }
County of Marion } ss.

This is to certify that the foregoing Registration Statement was received in the office of the State Engineer on the 14 day of July, 1958, at 8:00 o'clock A.M. and has been duly recorded in said office in Book No. 9 of Registration Statements on page GR-2023

Witness my hand this 16th day of February, 1959

Laura A. Stanley
(State Engineer)

\$ 25.85

By _____
(Deputy)