

RECEIVED
JUL 14 1958
STATE ENGINEER
SALEM, OREGON

REGISTRATION NO. GR-2167
CERTIFICATE NO. GR-2025

Registration Statement

OF CLAIMANT OF RIGHT TO APPROPRIATE GROUND WATER

(Under Chapter 708, Oregon Laws 1955.)

TO THE STATE ENGINEER OF OREGON:

I, Elmer T. Etzel

of Stayton County of Marion

State of Oregon, do hereby make application for a certificate of registration as evidence of a right to appropriate ground water.

1. Source from which water is withdrawn is Pump Well
(Flowing well, pump well, infiltration trench, or tunnel)

2. Location is: 5 1/2 miles North East of Stayton
(Approximate distance and direction from nearest city or town)

and is more particularly described as follows:

(a) East 1840' and South 216' to N.E. Corner of Philemon Morris D.L.C.
(Give distance and bearing to corner of section or other legal subdivision)

being within N 1/4 of SW 1/4 of Sec. 4, Twp. 9 S, Rge. 1 E
(Smallest legal subdivision) (N. or S.) (E. or W.)

or (b) within limits of recorded platted property, town or city:

in Lot _____, Block _____ of _____
(Name of plat or addition)

(If within city or town, give name) _____ County of _____

3. Construction Work was begun on Aug. 1, 1952; was completed on Oct. 15, 1952
(Date) (Date)

and the ground water claimed was first used for the purposes set out below on June 1, 1953
(Date)

since which time the water has been used Continuously
(Continuously or intermittently)

from May 15 to October 1
(Date) (Date)

4. Quantity of water claimed and used is 250 gallons per minute; _____ acre feet per year.

5. Purpose or Purposes for which water is used Irrigation

(Domestic, irrigation, municipal, manufacturing, industrial, etc.)

6. Description of Well: Depth 380 feet. Type drilled

(Dug or drilled)

diameter 6" inches. Elevation of ground at well site _____ feet, mean sea level.

(As near as known)

Depth to water table _____ feet. no appreciable drawdown

7. Capacity of Well: 250 g.p.m. with _____ feet drawdown.

See Remarks

_____ g.p.m. with _____ feet drawdown.

Near Oct.

Date of test _____

If Flowing Well: Measured discharge _____ g.p.m. on _____

(Date)

Shut-in pressure at ground surface _____ lbs. per sq. in. on _____

(Date)

Water is controlled by _____

(Cap, valve, etc.)

8. **Casing:** (Give diameter, commercial specifications and depth below ground surface of each casing size.)

6" inch diameter from 0 to 7 feet
 inch diameter from to feet
 inch diameter from to feet
 inch diameter from to feet

Describe and show depth of shoe, plug, adapter, liner or other details:

9. **Perforated Casings or Screens:**

Now necessary from to
(Number per foot and size of perforations, or describe screen)
 from to
 from to
 from to

10. **Log of Well:** (Describe each stratum or formation clearly, indicate if water bearing, and give thickness and depth as indicated.)

MATERIAL	Thickness (Feet)	Depth to Bottom (Feet)
Dirt	7	7
Rock varying in hardness 373'		
There is Black Basalt from	220	380

If log of well is not available, give name and address of driller. J. W. Beak

Canby, Oregon

11. Infiltration Trench: Covered or open

Dimensions: Length ft. Minimum depth ft. Maximum depth ft.

Bottom width ft. Discharge g.p.m. Date of test

12. Tunnel: Type of lining

Dimensions:
(Length, course, and cross sectional size)

Position of water bearing stratum with reference to portal of tunnel

Log of tunnel: (Preceding table for log of well may be used, if desired. Give footage from portal and character of materials, as pertinent.)

13. Pumping Equipment:

(a) Pump Deep well turbine Capacity 250 to 350 g.p.m.
(Make, type and size)

(b) Motor 40 H.P. Electric
(Type and horsepower)


14. Location of area irrigated or to be irrigated, or place of use if for purposes other than irrigation.

Township North or South	Range E. or W. of Willamette Meridian	Section	Forty-acre Tract	Number Acres To Be Irrigated	Date of Reclamation
Irrigated 9 S	1 E	4	SW $\frac{1}{4}$ of NW $\frac{1}{4}$	25	1953
			SE $\frac{1}{4}$ of NW $\frac{1}{4}$	15	"
			NE $\frac{1}{4}$ of SW $\frac{1}{4}$	10	"
			NW $\frac{1}{4}$ of SW $\frac{1}{4}$	20	"
					<u>70 Total</u>
To be irrigated 9 S	1 E	4	SW $\frac{1}{4}$ of NE $\frac{1}{4}$	20	<i>Not irrigated prior to 1958</i>
			SE $\frac{1}{4}$ of NW $\frac{1}{4}$	20	
			NE $\frac{1}{4}$ of SW $\frac{1}{4}$	20	
			NW $\frac{1}{4}$ of SE $\frac{1}{4}$	20	
Remarks: It appears to me that this well is capable of caring for this above indicated area to be irrigated. In any event I desire to rotate crops by use of this area in conjunction with the area now being irrigated.					

15. If the ground water supply is supplemental to an existing water supply, identification of any application for a permit, permit, certificate or adjudicated right to appropriate water made or held by the registrant.

Township 95 Range 1E W.M.

North

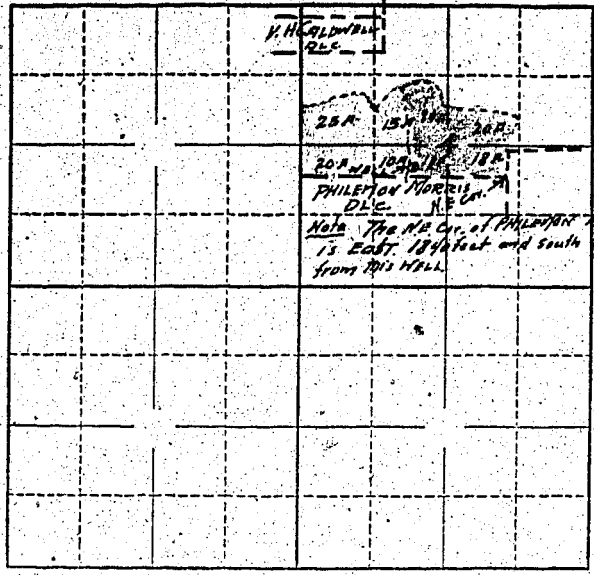

LEGEND
 Area now irrigated
 " proposed to be added
 to irrigated area from
 this well. See
 Remarks

File Permit for this

Locate well and acreage of irrigated land on plat.
Scale: 2" = 1 Mile

STATE OF OREGON

County of Marion } ss.

I, Elmer T. Egel, being first duly sworn, do hereby certify that I have read the foregoing Registration Statement and that all of the items therein contained are true to the best of my knowledge and belief.

Elmer T. Egel
(Signature of Registrant)

Subscribed and sworn to before me this 11 day of July, 1958

My commission expires 8/21/58

Harriet S. Sees
(Notary Public)

(SEAL)

CERTIFICATE OF REGISTRATION

STATE OF OREGON } ss.
County of Marion

This is to certify that the foregoing Registration Statement was received in the office of the State Engineer on the 14 day of July, 1958, at 8:00 o'clock A. M. and has been duly recorded in said office in Book No. 9 of Registration Statements on page GR-2025

~~Construction shall be completed by 12/31/58 and the water completely applied to beneficiaries by 12/31/58~~

Witness my hand this 16th day of February, 1959

Laura A. Standen
(State Engineer)

21⁰⁰

By _____ (Deputy)

GR-2025