

RECEIVED  
JUL 14 1958  
STATE ENGINEER  
SALEM, OREGON

Registration No. GR. 2115

Certificate No. GR. 2033

# Registration Statement

## OF CLAIMANT OF RIGHT TO APPROPRIATE GROUND WATER

TO THE STATE ENGINEER OF OREGON:

I, W. E. Barker

of Rt. 2, Box 227 C, Albany  
(Mailing address)

County of Linn

State of Oregon, do hereby make application for a certificate of registration as evidence of a right to appropriate ground water.

1. Source from which water is withdrawn is Pump Well No. 2  
(Flowing well, pump well, infiltration trench, or tunnel)

2. Location is: 1 1/2 miles north of Lebanon, Oregon  
(Approximate distance and direction from nearest city or town)

and is more particularly described as follows:

(a) 500' N. and 760' W. of SE corner of NE 1/4 of S. 21, T. 11 S., R. 2 W.  
(Give distance and bearing to corner of section or other legal subdivision)

being within SE 1/4 of NE 1/4 of Sec. 21, Twp. 11 S, Rge. 2 W  
(Smallest legal subdivision) (N. or S.) (E. or W.)

or (b) within limits of recorded platted property, town or city:

in Lot \_\_\_\_\_, Block \_\_\_\_\_ of \_\_\_\_\_  
(Name of plat or addition)

County of Linn  
(If within city or town, give name)

3. Construction Work was begun on 1952; was completed on 1952  
(Date) (Date)

and the ground water claimed was first used for the purposes set out below on 1952  
(Date)

since which time the water has been used Intermittently  
(Continuously or intermittently)

from 1952 to present time  
(Date) (Date)

4. Quantity of water claimed and used is 110 gallons per minute; 57.0 acre feet per year.

5. Purpose or Purposes for which water is used Irrigation

(Domestic, irrigation, municipal, manufacturing, industrial, etc.)

6. Description of Well: Depth 40 feet. Type Drilled  
(Dug or drilled)

diameter 6 inches. Elevation of ground at well site 230 feet, mean sea level.  
(As near as known)

Depth to water table 3.5 feet.

7. Capacity of Well: \_\_\_\_\_ g.p.m. with \_\_\_\_\_ feet drawdown.

\_\_\_\_\_ g.p.m. with \_\_\_\_\_ feet drawdown.

Date of test Not Tested

If Flowing Well: Measured discharge \_\_\_\_\_ g.p.m. on \_\_\_\_\_  
(Date)


Shut-in pressure at ground surface \_\_\_\_\_ lbs. per sq. in. on \_\_\_\_\_  
(Date)

Water is controlled by Cap  
(Cap, valve, etc.)





Township 11 S Range 2 W, W.M.  
North

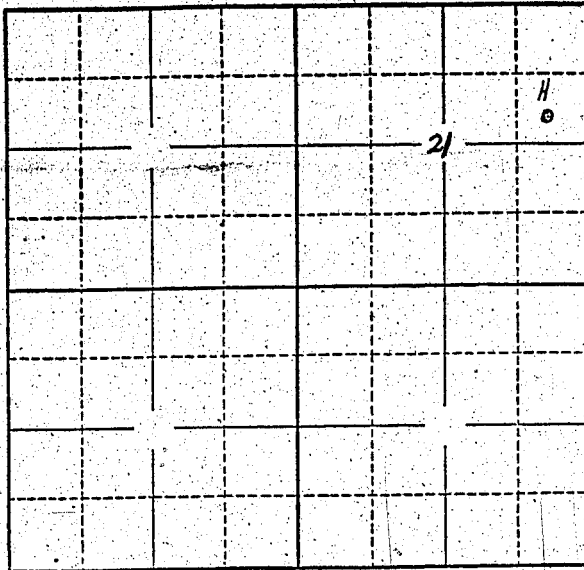

Locate well and acreage of irrigated land on plat.  
Scale: 2" = 1 Mile

STATE OF OREGON

County of LINN

} ss.

I, W. E. Barker, being first duly sworn, do hereby certify that I have read the foregoing Registration Statement and that all of the items therein contained are true to the best of my knowledge and belief.

W. E. Barker  
(Signature of Registrant)

Subscribed and sworn to before me this 10th day of July, 1958

My commission expires

NOTARY PUBLIC

W. E. Hackman  
(Notary Public)

(SEAL)

**CERTIFICATE OF REGISTRATION**

STATE OF OREGON

County of Marion

} ss.

This is to certify that the foregoing Registration Statement was received in the office of the State Engineer on the 14 day of July, 1958, at 8:00 o'clock A.M. and has been duly recorded in said office in Book No. 9 of Registration Statements on page GR-2033

Witness my hand this 16th day of February

19 59

Lewis A. Stanley  
(State Engineer)

By

(Deputy)

#15.00

GR - 2033