

RECEIVED
MAY 12 1958

STATE ENGINEER
SALEM, OREGON

Registration Statement

REGISTRATION NO. GR-2117

CERTIFICATE NO. GR-2035

OF CLAIMANT OF RIGHT TO APPROPRIATE GROUND WATER

(Under Chapter 708, Oregon Laws 1955.)

TO THE STATE ENGINEER OF OREGON:

I, Eldon Snider

of Rt. 2 Box 933, Troutdale County of Multnomah

State of Oregon, do hereby make application for a certificate of registration as evidence of a right to appropriate ground water.

1. Source from which water is withdrawn is pump well #3
(Flowing well, pump well, infiltration trench, or tunnel)

2. Location is: 2 Mi. NE of Gresham, Oregon
(Approximate distance and direction from nearest city or town)

and is more particularly described as follows:

(a) See map 2400' east and 50' north of the SW corner of Section 35
SE $\frac{1}{4}$ SE $\frac{1}{4}$ SW $\frac{1}{4}$ (Give distance and bearing to corner of section or other legal subdivision)
being within Benj. & Emily Hall D.L.C. of Sec. 35, Twp. 1N, Rge. 3E
(Smallest legal subdivision) (N. or S.) (E. or W.)

or (b) within limits of recorded platted property, town or city: _____

in Lot _____, Block _____ of _____
(Name of plat or addition)

County of _____
(If within city or town, give name)

3. Construction Work was begun on 1946; was completed in spring 1946
(Date) (Date)

and the ground water claimed was first used for the purposes set out below on same
(Date)

since which time the water has been used intermittently
(Continuously or intermittently)

from 1946 to present
(Date) (Date)

4. Quantity of water claimed and used is 50 gallons per minute; _____ acre feet per year.

5. Purpose or Purposes for which water is used industrial

(Domestic, irrigation, municipal, manufacturing, industrial, etc.)

6. Description of Well: Depth 90 feet. Type drilled
(Dug or drilled)

diameter 6 inches. Elevation of ground at well site 322 feet, mean sea level.
(As near as known)

Depth to water table _____ feet.

7. Capacity of Well: 50 g.p.m. with _____ feet drawdown.

_____ g.p.m. with _____ feet drawdown.


Date of test _____

If Flowing Well: Measured discharge _____ g.p.m. on _____
(Date)

Shut-in pressure at ground surface _____ lbs. per sq. in. on _____
(Date)

Water is controlled by _____
(Cap, valve, etc.)

Township 1N Range 3E, W.M.
North

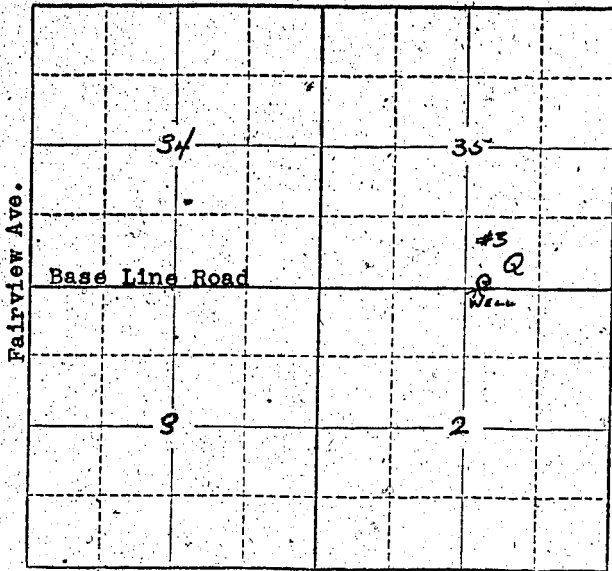

Locate well and acreage of irrigated land on plat.
Scale: 2" = 1 Mile

STATE OF OREGON

County of Multnomah } ss.

I, Eldon Snider, being first duly sworn, do hereby certify that I have read the foregoing Registration Statement and that all of the items therein contained are true to the best of my knowledge and belief.

Eldon Snider
(Signature of Registrant)

Subscribed and sworn to before me this 9th day of May, 1958

My commission expires _____
MY COMMISSION EXPIRES SEPT. 23, 1960

(Notary Public)

(SEAL)

CERTIFICATE OF REGISTRATION

STATE OF OREGON

County of Marion } ss.

This is to certify that the foregoing Registration Statement was received in the office of the State Engineer on the 12th day of May, 1958, at 8.00 o'clock A. M. and has been duly recorded in said office in Book No. 9 of Registration Statements on page GR-2035

Witness my hand this 16th day of February, 1959

Lewis A. Stanley
(State Engineer)

By _____ (Deputy)

\$20.00

GR-2035