

RECEIVED
MAY 12 1958
STATE ENGINEER
SALEM, OREGON

Registration Statement

REGISTRATION NO. GR-2118
CERTIFICATE NO. GR-2036

OF CLAIMANT OF RIGHT TO APPROPRIATE GROUND WATER

(Under Chapter 708, Oregon Laws 1955.)

TO THE STATE ENGINEER OF OREGON:

I, Eldon Snider

of Rt. 2 Box 933 Troutdale County of Multnomah

State of Oregon, do hereby make application for a certificate of registration as evidence of a right to appropriate ground water:

1. Source from which water is withdrawn is pump well #1
(Flowing well, pump well, infiltration trench, or tunnel)

2. Location is: 2 miles NE of Gresham
(Approximate distance and direction from nearest city or town)

and is more particularly described as follows:

(a) 2320' west and 200' north of the SW corner of Section 35
(Give distance and bearing to corner of section or other legal subdivision)

being within SE1 SE4 SW4 of Sec. 30, Twp. 1 North, Rge. 3 East
(Smallest legal subdivision) (N. or S.) (E. or W.)

or (b) within limits of recorded platted property, town or city:

in Lot _____, Block _____ of _____
(Name of plat or addition)

County of _____
(If within city or town, give name)

3. Construction Work was begun on 1950; was completed on _____
(Date) (Date)

and the ground water claimed was first used for the purposes set out below on April 26, 1950
(Date)

since which time the water has been used continuously
(Continuously or intermittently)

from 4-26-50 to present
(Date) (Date)

4. Quantity of water claimed and used is 200 gallons per minute; _____ acre feet per year.

5. Purpose or Purposes for which water is used irrigation and industrial

(Domestic, irrigation, municipal, manufacturing, industrial, etc.)

6. Description of Well: Depth 135 feet. Type drilled
(Dug or drilled)

diameter 10 inches. Elevation of ground at well site 322 feet, mean sea level.
(As near as known)

Depth to water table _____ feet.

7. Capacity of Well: 150 g.p.m. with _____ feet drawdown,

100 g.p.m. with _____ feet drawdown.

Date of test 4-26-50

If Flowing Well: Measured discharge _____ g.p.m. on _____
(Date)

Shut-in pressure at ground surface _____ lbs. per sq. in. on _____
(Date)

Water is controlled by _____
(Cap, valve, etc.)

8. Casing: (Give diameter, commercial specifications and depth below ground surface of each casing size.)

10 inch diameter I.D. from 0 to 125 feet
 inch diameter from to feet
 inch diameter from to feet
 inch diameter from to feet

Describe and show depth of shoe, plug, adapter, liner or other details:

9. Perforated Casings or Screens:

Casing Perforated from 50' to 70'
 (Number per foot and size of perforations, or describe screen)
 " " from 100' to 112'
 " " from 111' to 120'
 from to 42'

10. Log of Well: (Describe each stratum or formation clearly, indicate if water bearing, and give thickness and depth as indicated.)

MATERIAL	Thickness (Feet)	Depth to Bottom (Feet)
Topsoil	2'	133'
Gravel and boulders	15'	148'
Cemented gravel and boulders (small)	11'	159'
Loose sand and gravel (water bearing formation)	12'	171'
Cemented gravel	10'	181'
Sandy clay	10'	191'
Cemented gravel	14'	205'
Loose sand and gravel (water bearing formation)	10'	215'
Loose gravel and boulders in clay	6'	221'
Loose gravel and boulders		

If log of well is not available, give name and address of driller.

R. J. Strasser Drilling Co., 8110 SE Sunset Lane, Portland, Ore.

11. Infiltration Trench: Covered or open

Dimensions: Length _____ ft. Minimum depth _____ ft. Maximum depth _____ ft.

Bottom width _____ ft. Discharge _____ g.p.m. Date of test _____

12. Tunnel: Type of lining

Dimensions: _____
(Length, course, and cross sectional size)

Position of water bearing stratum with reference to portal of tunnel _____

Log of tunnel: (Preceding table for log of well may be used, if desired. Give footage from portal and character of materials, as pertinent.)

13. Pumping Equipment:

(a) Pump Flowless Turbine Type Capacity g.p.m.
(Make, type and size)


(b) Motor Hastingshouse 15 H.P.
(Type and horsepower)

14. Location of area irrigated or to be irrigated, or place of use if for purposes other than irrigation.

Township North or South	Range E. or W. of Willamette Meridian	Section	Forty-acre Tract	Number Acres To Be Irrigated	Date of Reclamation
1N	3E	35	NW $\frac{1}{4}$ SE $\frac{1}{4}$	27.6	4-26-50
"	"	"	SW $\frac{1}{4}$ SE $\frac{1}{4}$	14.0	4-26-50
"	"	"	NE $\frac{1}{4}$ SW $\frac{1}{4}$	6.4	4-26-50
"	"	"	SE $\frac{1}{4}$ SW $\frac{1}{4}$	12.0	4-26-50
1S	3E	2	NE $\frac{1}{4}$ NW $\frac{1}{4}$	21.6	10-7-52
				81.6	

15. If the ground water supply is supplemental to an existing water supply, identification of any application for a permit, permit, certificate or adjudicated right to appropriate water made or held by the registrant.

Township 1 N Range 3 E W.M.
15 North

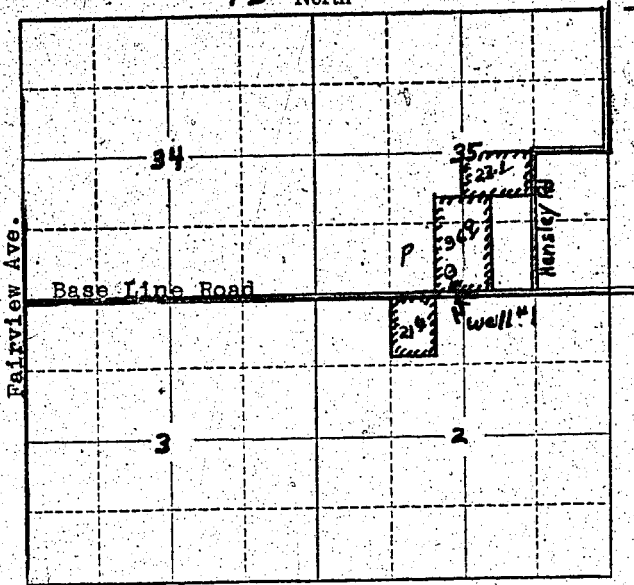

Locate well and acreage of irrigated land on plat.
 Scale: 2" = 1 Mile

STATE OF OREGON }
 County of Multnomah } ss.

I, Eldon Snider, being first duly sworn, do hereby certify that I have read the foregoing Registration Statement and that all of the items therein contained are true to the best of my knowledge and belief.

Eldon Snider
 (Signature of Registrant)

Subscribed and sworn to before me this 9th day of May, 19 58.

My commission expires SEPT. 23, 1960
 (SEAL) MY COMMISSION EXPIRES SEPT. 23, 1960 (Notary Public)

CERTIFICATE OF REGISTRATION

STATE OF OREGON }
 County of Marion } ss.

This is to certify that the foregoing Registration Statement was received in the office of the State Engineer on the 14 day of July, 19 58, at 8:00 o'clock A. M. and has been duly recorded in said office in Book No. 9 of Registration Statements on page GR-2036

Witness my hand this 16th day of February, 19 59

Lewis A. Stanley
 (State Engineer)

32 30

By _____ (Deputy)

GR-2036