

RECEIVED
JUL 14 1958
STATE ENGINEER
SALEM, OREGON

Registration No. GR - 2119

Certificate No. GR 3847

Registration Statement

OF CLAIMANT OF RIGHT TO APPROPRIATE GROUND WATER

TO THE STATE ENGINEER OF OREGON:

I, True E. Daniels

of Rt. 4, Box 327A Corvallis County of Linn

(Mailing address)

State of Oregon, do hereby make application for a certificate of registration as evidence of a right to appropriate ground water.

1. Source from which water is withdrawn is Pump Well

(Flowing well, pump well, infiltration trench, or tunnel)

2. Location is: 2 miles East of Corvallis

(Approximate distance and direction from nearest city or town)

and is more particularly described as follows:

(a) N 61° 15' W, 126' from South East corner D1C 487

(Give distance and bearing to corner of section or other legal subdivision)

being within SW 1/4 SE 1/4 of Sec. 31, Twp. 11S, Rge. 1W

(Smallest legal subdivision)

(N. or S.)

(E. or W.)

or (b) within limits of recorded platted property, town or city:

in Lot _____, Block _____ of _____

(Name of plat or addition)

County of _____

(If within city or town, give name)

3. Construction Work was begun on Spring 1952; was completed on Mar. 1952

(Date)

(Date)

and the ground water claimed was first used for the purposes set out below on Mar. 1952

(Date)

since which time the water has been used Intermittently

(Continuously or Intermittently)

from April to October

(Date)

(Date)

4. Quantity of water claimed and used is 80 gallons per minute; _____ acre feet per year.

5. Purpose or Purposes for which water is used Irrigation

(Domestic, irrigation, municipal, manufacturing, industrial, etc.)

6. Description of Well: Depth 30 feet. Type Dug

(Dug or drilled)

diameter 18 inches. Elevation of ground at well site _____ feet, mean sea level.

(As near as known)

Depth to water table 13 feet.

7. Capacity of Well: _____ g.p.m. with no test feet drawdown.

_____ g.p.m. with _____ feet drawdown.

Date of test _____

If Flowing Well: Measured discharge _____ g.p.m. on _____

(Date)


Shut-in pressure at ground surface _____ lbs. per sq. in. on _____

(Date)

Water is controlled by _____

(Cap, valve, etc.)

Township 11.5 Range 4W, W.M.
North

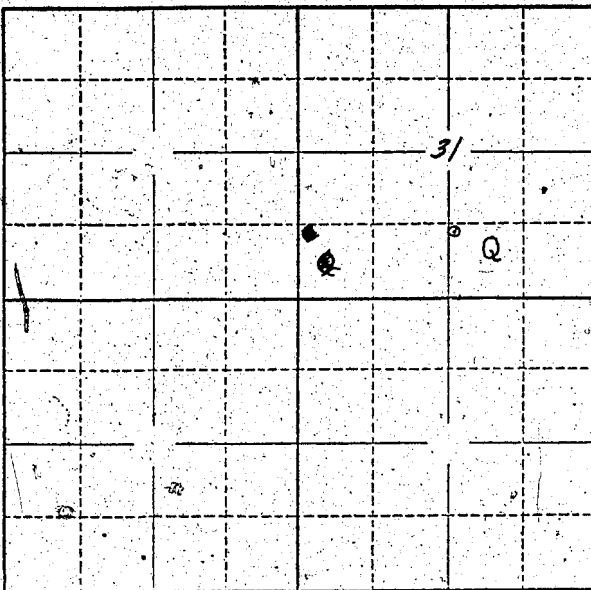

Locate well and acreage of irrigated land on plat.
Scale: 2" = 1 Mile

STATE OF OREGON

County of Linn } ss.

I, True E. Daniels being first duly sworn, do hereby certify that I have read the foregoing Registration Statement and that all of the items therein contained are true to the best of my knowledge and belief.

True E. Daniels
(Signature of Registrant)

Subscribed and sworn to before me this 14th day of July, 1958

My commission expires 12th June 1961 Wm. S. Bartholomew
(Notary Public)

(SEAL)

CERTIFICATE OF REGISTRATION

STATE OF OREGON

County of Marion } ss.

This is to certify that the foregoing Registration Statement, was received in the office of the State Engineer on the 14 day of July, 1958, at 8.00 o'clock A.M. and has been duly recorded in said office in Book No. 16 of Registration Statements on page GR-3817

Witness my hand this 28th day of December, 1959

Lawrence A. Stanley
(State Engineer)

By _____
(Deputy)

GR 3817

15.00