

Registration Statement **CERTIFICATE** NO. GR-197

OF CLAIMANT OF RIGHT TO APPROPRIATE GROUND WATER
(Under Chapter 708, Oregon Laws 1953.)

TO THE STATE ENGINEER OF OREGON:

I, DAVID GERIG

of R#1, Box 92, BROOKS County of Marion

State of Oregon, do hereby make application for a certificate of registration as evidence of a right to appropriate ground water.

1. Source from which water is withdrawn is Pump Well
(Flowing well, pump well, infiltration trench, or tunnel)

2. Location is: 3.2 miles West of Mt. Angel
(Approximate distance and direction from nearest city or town)

and is more particularly described as follows:

(a) N. 29° 57' W. 21.52 chains from the most South Southwest corner W. Parker Claim
(Give distance and bearing to corner of section or other legal subdivision)

being within 1/4 NW 1/4 of NE 1/4 of Sec. 7, Twp. 6 S., Rge. 1 W.
(Smallest legal subdivision) (N. or S.) (E. or W.)

or (b) within limits of recorded platted property, town or city:

in Lot _____, Block _____ of _____
(Name of plat or addition)
County of Marion
(If within city or town, give name)

3. Construction Work was begun on Sept. 1949; was completed on Sept. 1949
(Date) (Date)

and the ground water claimed was first used for the purposes set out below on Dec. 1, 1949
(Date)

since which time the water has been used Continuously
(Continuously or intermittently)

from Dec. 1, 1949 to Present time
(Date) (Date)

4. Quantity of water claimed and used is 60 gallons per minute; _____ acre feet per year.

5. Purpose or Purposes for which water is used _____

Domestic and Irrigation
(Domestic, irrigation, municipal, manufacturing, industrial, etc.)

6. Description of Well: Depth 113 feet. Type drilled
(Dug or drilled)

diameter 8 inches. Elevation of ground at well site _____ feet, mean sea level.
(As near as known)

Depth to water table 50 feet.

7. Capacity of Well: _____ g.p.m. with _____ feet drawdown.

_____ g.p.m. with _____ feet drawdown. not tested, but pumps 60 Gal. a minute

Date of test _____

If Flowing Well: Measured discharge _____ g.p.m. on _____
(Date)

Shut-in pressure at ground surface _____ lbs. per sq. in. on _____
(Date)

Water is controlled by _____
(Cap, valve, etc.)

8. Casing: (Give diameter, commercial specifications and depth below ground surface of each casing size.)

8 inch diameter *steel casing* from *0* to *113* feet
 inch diameter from to feet
 inch diameter from to feet
 inch diameter from to feet

Describe and show depth of shoe, plug, adapter, liner or other details:

9. Perforated Casings or Screens

unknown from to
 (Number per foot and size of perforations, or describe screen)
 from to
 from to
 from to

10. Log of Well: (Describe each stratum or formation clearly, indicate if water bearing, and give thickness and depth as indicated.)

MATERIAL	Thickness (Feet)	Depth to Bottom (Feet)
<i>not available</i>		

If log of well is not available, give name and address of driller.

J. A. Sneed & Sons, 2505 Brooks Ave., Salem, Oregon

11. Infiltration Trench: Covered or open _____

Dimensions: Length _____ ft. Minimum depth _____ ft. Maximum depth _____ ft.

Bottom width _____ ft. Discharge _____ g.p.m. Date of test _____

12. Tunnel: Type of lining _____

Dimensions: _____
(Length, course, and cross sectional size)

Position of water bearing stratum with reference to portal of tunnel _____

Log of tunnel: (Preceding table for log of well may be used, if desired. Give footage from portal and character of materials, as pertinent.)

13. Pumping Equipment:

(a) Pump Universal, 5 horsepower, Jet type Capacity 60 g.p.m.
(Make, type and size)


(b) Motor 5 horsepower single phase
(Type and horsepower)

14. Location of area irrigated or to be irrigated, or place of use if for purposes other than irrigation.

Township North or South	Range E. or W. of Williams Meridian	Section	Forty-acre Tract	Number Acres To Be Irrigated	Date of Reclamation
6 S.	1 W.	7	NW. $\frac{1}{4}$ of NE. $\frac{1}{4}$	10.0	1950

15. If the ground water supply is supplemental to an existing water supply, identification of any application for a permit, permit, certificate or adjudicated right to appropriate water made or held by the registrant.

Township T6S Range R1W, W.M.
North

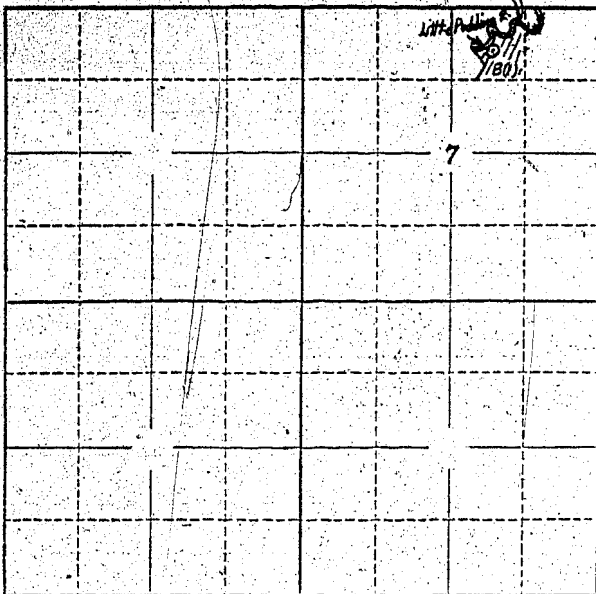

Locate well and acreage of irrigated land on plat.
Scale: 2" = 1 Mile

STATE OF OREGON }
County of _____ } ss.

I, David Gerig, being first duly sworn, do hereby certify that I have read the foregoing Registration Statement and that all of the items therein contained are true to the best of my knowledge and belief.

David Gerig
(Signature of Registrant)

Subscribed and sworn to before me this 20th day of July, 1956.

My commission expires Sept 8th, 1956

David Gerig also sworn
(Notary Public)

(SEAL)

CERTIFICATE OF REGISTRATION

STATE OF OREGON }
County of Marion } ss.

This is to certify that the foregoing Registration Statement was received in the office of the State Engineer on the 20th day of July, 1956, at _____ o'clock _____ A. M. and has been duly recorded in said office in Book No. 7 of Registration Statements on page GR-197 C.

~~Construction shall be completed by _____ and the water completely applied in _____~~
~~_____ by _____~~

Witness my hand this 23rd day of November, 1956.

Levin A. Stanley
(State Engineer)

By _____
(Deputy)

GR-197C