

RECEIVED
JUL 14 1958
STATE ENGINEER
ALEX. C. JOHNSON

REGISTRATION NO. GR-2120
CERTIFICATE NO. GR-3848

Registration Statement

OF CLAIMANT OF RIGHT TO APPROPRIATE GROUND WATER

(Under Chapter 703, Oregon Laws 1955.)

TO THE STATE ENGINEER OF OREGON:

I, True W. Daniels
of Rt. 1, Box 327A, Corvallis County of Linn
State of Oregon, do hereby make application for a certificate of registration as evidence
of a right to appropriate ground water.

1. Source from which water is withdrawn is Pump well #2
(Flowing well, pump well, infiltration trench, or tunnel)

2. Location is: 2 miles East of Corvallis
(Approximate distance and direction from nearest city or town)

and is more particularly described as follows:

(a) S71° 20' W - 1861' from South East Corner D1C #37
(Give distance and bearing to corner or section or other legal subdivision)

being within SW 1/4 SE 1/4 of Sec. 31, Twp. 11, Rge. 11W
(Smallest legal subdivision) (N. or S.) (E. or W.)

or (b) within limits of recorded platted property, town or city:

in Lot _____, Block _____ of _____
(Name of plat or addition)

County of _____
(If within city or town, give name)

3. Construction Work was begun on Sept., 1954, was completed on _____
(Date) (Date)

and the ground water claimed was first used for the purposes set out below on _____
(Date)

since which time the water has been used Intermittently
(Continuously or Intermittently)

from April to October
(Date) (Date)

4. Quantity of water claimed and used is 80 gallons per minute; _____ acre
feet per year.

5. Purpose or Purposes for which water is used Irrigation

(Domestic, irrigation, municipal, manufacturing, industrial, etc.)

6. Description of Well: Depth 30 feet. Type Dug
(Dug or drilled)

diameter 12 inches. Elevation of ground at well site _____ feet, mean sea level.
(As near as known)

Depth to water table 13 feet.

7. Capacity of Well: _____ g.p.m. with No test feet drawdown.

_____ g.p.m. with _____ feet drawdown.

Date of test _____


If Flowing Well: Measured discharge _____ g.p.m. on _____
(Date)

Shut-in pressure at ground surface _____ lbs. per sq. in. on _____
(Date)

Water is controlled by _____
(Cap, valve, etc.)

Well #2 is a supplemental well for irrigation to well #1 and both
are not used at the same time.

Township 11 S Range 4 W, W.M.
North

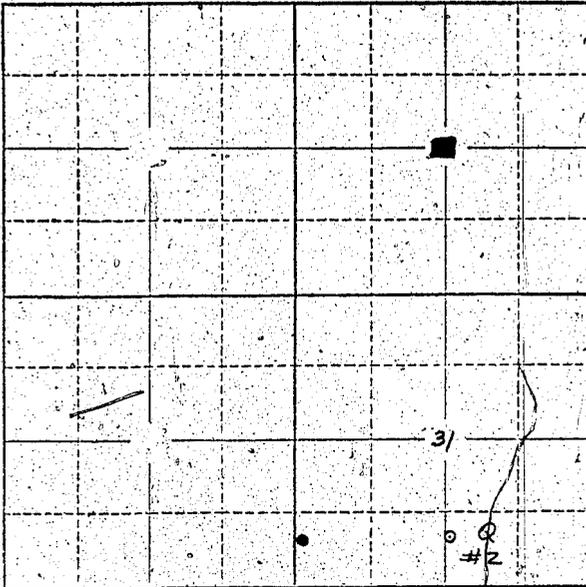

Locate well and acreage of irrigated land on plat.

Scale: 2" = 1 Mile

STATE OF OREGON

County of Linn } ss.

I, True E. Daniels, being first duly sworn, do hereby certify that I have read the foregoing Registration Statement and that all of the items therein contained are true to the best of my knowledge and belief.

True E. Daniels
(Signature of Registrant)

Subscribed and sworn to before me this 14th day of July, 1958.

My commission expires 12th June 1961 Wm. S. Bartholomew
(Notary Public)

(SEAL)

CERTIFICATE OF REGISTRATION

STATE OF OREGON

County of Marion } ss.

This is to certify that the foregoing Registration Statement was received in the office of the State Engineer on the 14 day of July, 1958, at 8:00 o'clock A. M. and has been duly recorded in said office in Book No. 16 of Registration Statements on page GR-3818

~~Construction shall be completed by 1959 and the water completely applied for beneficial use by 1959.~~

Witness my hand this 28 day of December, 1959

Wm. S. Bartholomew
(State Engineer)

By _____
(Deputy)

GR-3818

\$15.00