

# Registration Statement

## OF CLAIMANT OF RIGHT TO APPROPRIATE GROUND WATER

TO THE STATE ENGINEER OF OREGON:

I, John C. Luscher  
of Rt. 2, Box 116 E, Lebanon County of Linn  
(Mailing address)

State of Oregon, do hereby make application for a certificate of registration as evidence of a right to appropriate ground water.

1. Source from which water is withdrawn is Pump well  
(Flowing well, pump well, infiltration trench, or tunnel)

2. Location is: 2 miles SW of Lebanon, Oregon  
(Approximate distance and direction from nearest city or town)

and is more particularly described as follows: See MAP

(a) about 2200 feet E. of 1900 ft. N. from  
1100' N. and 1702' E. of SW corner S. 16, T. 12 S, R. 2 W  
(Give distance and bearing to corner of section or other legal subdivision)

being within NE 1/4 of SW 1/4 of Sec. 21, Twp. 12 S, Rge. 2 W  
(Smallest legal subdivision) (N. or S.) (E. or W.)

or (b) within limits of recorded platted property, town or city:

in Lot \_\_\_\_\_, Block \_\_\_\_\_ of \_\_\_\_\_  
(Name of plat or addition)

County of Linn  
(If within city or town, give name)

3. Construction Work was begun on March 1952; was completed on March 1952  
(Date) (Date)

and the ground water claimed was first used for the purposes set out below on May 1952  
(Date)

since which time the water has been used continuously  
(Continuously or Intermittently)

from May 1952 to present time  
(Date) (Date)

4. Quantity of water claimed and used is 100 gallons per minute; 50.4 acre feet per year.

5. Purpose or Purposes for which water is used Irrigation  
(Domestic, irrigation, municipal, manufacturing, industrial, etc.)

6. Description of Well: Depth 54 feet. Type Drilled  
(Dug or drilled)

diameter 12 inches. Elevation of ground at well site 320 feet, mean sea level.  
(As near as known)

Depth to water table 21 feet.

7. Capacity of Wells \_\_\_\_\_ g.p.m. with \_\_\_\_\_ feet drawdown.

\_\_\_\_\_ g.p.m. with \_\_\_\_\_ feet drawdown.

Date of test Not Tested

If Flowing Well: Measured discharge \_\_\_\_\_ g.p.m. on \_\_\_\_\_  
(Date)

Shut-in pressure at ground surface \_\_\_\_\_ lbs. per sq. in. on \_\_\_\_\_  
(Date)

Water is controlled by \_\_\_\_\_  
(Cap. valve, etc.)

8. Casing: (Give diameter, commercial specifications and depth below ground surface of each casing size.)

12 inch diameter steel casing from 0 to 50 feet  
inch diameter from to feet  
inch diameter from to feet  
inch diameter from to feet

Describe and show depth of shoe, plug, adapter, liner or other details:

9. Perforated Casings or Screens:

Slot perforations from 10 to 50  
(Number per foot and size of perforations, or describe screen)  
from to  
from to  
from to

10. Log of Well: (Describe each stratum or formation clearly, indicate if water bearing, and give thickness and depth as indicated.)

| MATERIAL      | Thickness (Feet) | Depth to Bottom (Feet) |
|---------------|------------------|------------------------|
| Not available |                  |                        |
|               |                  |                        |
|               |                  |                        |
If log of well is not available, give name and address of driller. Art Clinton, Independence, Oregon

11. Infiltration Trench: Covered or open \_\_\_\_\_

Dimensions: Length \_\_\_\_\_ ft. Minimum depth \_\_\_\_\_ ft. Maximum depth \_\_\_\_\_ ft.

Bottom width \_\_\_\_\_ ft. Discharge \_\_\_\_\_ g.p.m. Date of test \_\_\_\_\_

12. Tunnel: Type of lining \_\_\_\_\_

Dimensions: \_\_\_\_\_  
(Length, course, and cross sectional size)

Position of water bearing stratum with reference to portal of tunnel \_\_\_\_\_

Log of tunnel: (Preceding table for log of well may be used, if desired. Give footage from portal and character of materials, as pertinent.)

13. Pumping Equipment:

(a) Pump Layn Bowler Deep Well L<sup>n</sup> Capacity 510 g.p.m.  
(Make, type and size)


(b) Motor 7½ H. P. Electric  
(Type and horsepower)

14. Location of area irrigated or to be irrigated, or place of use if for purposes other than irrigation.

| Township North or South | Range E or W of Willamette Meridian | Section | Forty-acre Tract | Number Acres To Be Irrigated | Date of Reclamation |
|-------------------------|-------------------------------------|---------|------------------|------------------------------|---------------------|
| 12 S                    | 2 W                                 | 16      | NE¼ of SW¼       | 15.2                         | May 1952            |
| 12 S                    | 2 W                                 | 16      | NW¼ of SW¼       | 1.6                          | " "                 |
|                         |                                     |         |                  | 16.8                         |                     |
|                         |                                     |         |                  |                              |                     |
|                         |                                     |         |                  |                              |                     |
15. If the ground water supply is supplemental to an existing water supply, identification of any application for a permit, permit, certificate or adjudicated right to appropriate water made or held by the registrant.

Township 12 S Range 2 W, W.M.  
North

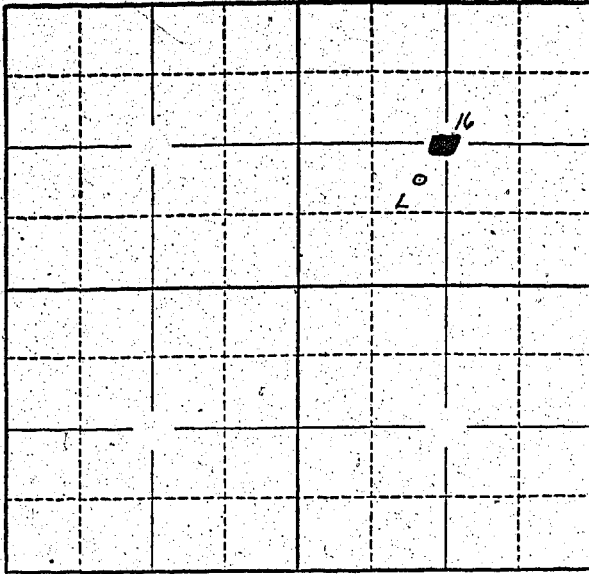

Locate well and acreage of irrigated land on plat.  
Scale: 2" = 1 Mile

STATE OF OREGON

County of LINN

} ss.

I, John C. Luscher, being first duly sworn, do hereby certify that I have read the foregoing Registration Statement and that all of the items therein contained are true to the best of my knowledge and belief.

John C. Luscher  
(Signature of Registrant)

Subscribed and sworn to before me this 3rd day of July, 1958

My commission expires November 27, 1959

Warney A. Smith  
(Notary Public for Oregon)

(SEAL)

### CERTIFICATE OF REGISTRATION

STATE OF OREGON

County of Marion

} ss.

This is to certify that the foregoing Registration Statement was received in the office of the State Engineer on the 14 day of July, 1958, at 8:00 o'clock A. M. and has been duly recorded in said office in Book No. 9 of Registration Statements on page GR-2040

Witness my hand this 29th day of February, 1959

Lewis A. Stanley  
(State Engineer)

By \_\_\_\_\_ (Deputy)

GR - 2040

\$15.00