REGISTRATION NO. GR-213

CERTIFICATE NO. GR-198

Registration Statement

OF CLAIMANT OF RIGHT TO APPROPRIATE GROUND WATER

(Under Chapter 708, Oregon Laws 1955.)

TO THE STATE ENGINEER OF OREGON:

I, Mary B. Dunaway,

of St Paul County of Marion

State of Oregon, do hereby make application for a certificate of registration as evidence of a right to appropriate ground water.

1. **Source** from which water is withdrawn is Well (Flowing well, pump well, infiltration trench, or tunnel)

2. **Location is:** 1 MILE - WEST - ST PAUL (Approximate distance and direction from nearest city or town);

and is more particularly described as follows:

(a) Approximately 1200 ft East and 100 ft So. of ~~NW 1/4 Sec~~ NW corner SW1/4 NE1/4 Section 24 (Give distance and bearing to corner of section or other legal subdivision)

being within SW1/4 NE1/4 (Smallest legal subdivision) of Sec. 24, Twp. 4 S (N. or S.), Rge. 3 W (E. or W.)

or (b) within limits of recorded platted property, town or city:

in Lot ____, Block ____ of ____ (Name of plat or addition)

____ (If within city or town, give name) County of ____

3. **Construction Work** was begun on Sept 1949 (Date); was completed on September 1949 (Date)

and the ground water claimed was first used for the purposes set out below on Summer 1950 (Date),

since which time the water has been used Continuously during irrigation Season (Continuously or intermittently)

from 1956 (Date) to 1956 (Date)

4. **Quantity** of water claimed and used is 210 gallons per minute; ____ acre feet per year.

5. **Purpose or Purposes** for which water is used Irrigation (Domestic, irrigation, municipal, manufacturing, industrial, etc.)

6. **Description of Well:** Depth ~~110~~ 121 feet. Type Drilled (Dug or drilled)

diameter 10 inches. Elevation of ground at well site 168 (As near as known) feet, mean sea level.

Depth to water table 32 feet. May 1, 1956

7. **Capacity of Well:** 600 g.p.m. with Pump set at 95 ft ~~feet drawdown~~.

____ g.p.m. with ____ feet drawdown.

Date of test 1949

If Flowing Well: Measured discharge ____ g.p.m. on ____ (Date)

Shut-in pressure at ground surface ____ lbs. per sq. in. on ____ (Date)

Water is controlled by ____ (Cap, valve, etc.)

8. **Casing:** (Give diameter, commercial specifications and depth below ground surface of each casing size.)

10 inch diameter from 0 to 110 feet

inch diameter from to feet

inch diameter from to feet

inch diameter from to feet

Describe and show depth of shoe, plug, adapter, liner or other details:

9. **Perforated Casings or Screens:**

None from to
(Number per foot and size of perforations, or describe screen)

from to

from to

from to

10. **Log of Well:** (Describe each stratum or formation clearly; indicate if water bearing, and give thickness and depth as indicated.)

MATERIAL	Thickness (Feet)	Depth to Bottom (Feet)
No Record		
Blue Clay		At 110 feet
Sand, gray	1	117
Pea gravel	2	119
Gravel, coarse	2	121

GR-198 A

If log of well is not available, give name and address of driller. J. T. Miller, Amity

11. **Infiltration Trench:** Covered or open .....

Dimensions: Length ..... ft. Minimum depth ..... ft. Maximum depth ..... ft.

Bottom width ..... ft. Discharge ..... g.p.m. Date of test .....

12. **Tunnel:** Type of lining .....

Dimensions: ..... (Length, course, and cross sectional size)

Position of water bearing stratum with reference to portal of tunnel .....

Log of tunnel: (Preceding table for log of well may be used, if desired. Give footage from portal and character of materials, as pertinent.)

13. **Pumping Equipment:**

(a) Pump Turbine (Peerless) (Make, type and size) Capacity 300 g.p.m.

(b) Motor 15 - H.P. (Type and horsepower)

14. Location of area irrigated or to be irrigated, or place of use if for purposes other than irrigation.

Township North or South	Range E. or W. of Willamette Meridian	Section	Forty-acre Tract	Number Acres To Be Irrigated	Date of Reclamation
4S	3 W	24	NE¼ NE¼	3	1950
			NW¼ NE¼	9	1950
			SW¼ NE¼	13	1950
				5	

15. If the ground water supply is supplemental to an existing water supply, identification of any application for a permit, permit, certificate or adjudicated right to appropriate water made or held by the registrant.

GR-198 B

Sec 24 Township 4 S Range 3 W, W.M.

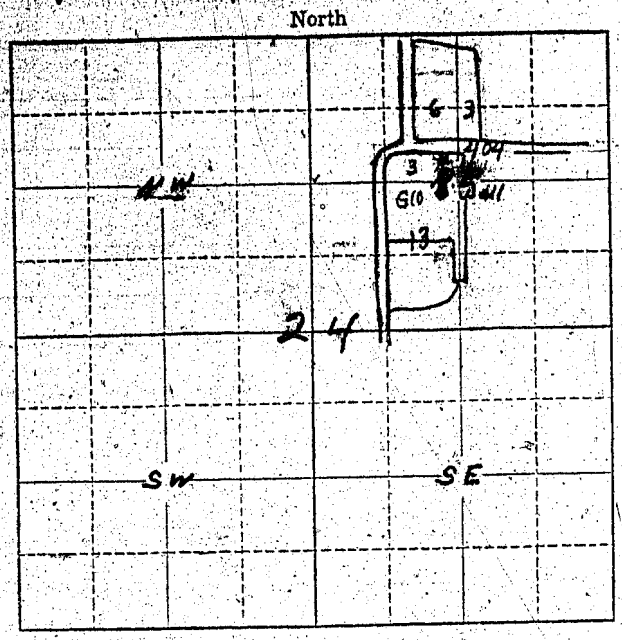

Locate well and acreage of irrigated land on plat.

Scale: 2" = 1 Mile

STATE OF OREGON
County of Marion } ss.

I, [illegible], being first duly sworn, do hereby certify that I have read the foregoing Registration Statement and that all of the items therein contained are true to the best of my knowledge and belief.

[illegible]
(Signature of Registrant)

Subscribed and sworn to before me this 27th day of July, 1956.

My commission expires Sept. 8, 1956

[illegible]
(Notary Public)

(SEAL)

CERTIFICATE OF REGISTRATION

STATE OF OREGON
County of Marion } ss.

This is to certify that the foregoing Registration Statement was received in the office of the State Engineer on the 27th day of July, 1956, at 8 o'clock A.M. and has been duly recorded in said office in Book No. 1 of Registration Statements on page GR-198 C.

~~Construction shall be completed by x-x-x-x-x-x-x-x-x-19-x-x and the water completely applied to beneficial use by x-x-x-x-x-x-x-x-x-19-x-~~

Witness my hand this 23rd day of November, 1956.

Lewis A. Stanley
(State Engineer)

By ..... (Deputy)

GR-198 C