

RECEIVED  
JUL 14 1958  
STATE ENGINEER

# Registration Statement

## SALEM, OREGON CLAIMANT OF RIGHT TO APPROPRIATE GROUND WATER

TO THE STATE ENGINEER OF OREGON:

I, RALPH E and GRACE A. CLARK  
of 810 RIVER LOOP 2 EUGENE ORE County of LANE  
(Mailing address)

State of ORE do hereby make application for a certificate of registration as evidence of a right to appropriate ground water.

1. Source from which water is withdrawn is PUMP WELL  
(Flowing well, pump well, infiltration trench, or tunnel)

2. Location is: 5 MILE N EUGENE  
(Approximate distance and direction from nearest city or town)

and is more particularly described as follows:

(a) 2326.5 FE east and 300 FE SOUTH of N.W. Corner B.W. Tract No. 121 C \*57  
(Give distance and bearing to corner of section or other legal subdivision)

being within NW 1/4 of SW 1/4 of Sec. 1, Twp. 17 S, Rge. T4 W. W.M.  
(Smallest legal subdivision) (N. or S.) (E. or W.)

or (b) within limits of recorded platted property, town or city:

in Lot \_\_\_\_\_, Block \_\_\_\_\_ of \_\_\_\_\_  
(Name of plat or addition)  
County of \_\_\_\_\_  
(If within city or town, give name)

3. Construction Work was begun on 1935; was completed on 1935  
(Date) (Date)

and the ground water claimed was first used for the purposes set out below on 1935  
(Date)

since which time the water has been used \_\_\_\_\_  
(Continuously or Intermittently)

from APRIL to Oct  
(Date) (Date)

4. Quantity of water claimed and used is 144 gallons per minute; 15 acre feet per year.

5. Purpose or Purposes for which water is used

IRRIG  
(Domestic, irrigation, municipal, manufacturing, industrial, etc.)

6. Description of Well: Depth 20 feet. Type DROVE  
(Dug or drilled)

diameter 2-(2 1/2) inches. Elevation of ground at well site \_\_\_\_\_ feet, mean sea level.  
(As near as known)

Depth to water table 15 feet.

7. Capacity of Well: \_\_\_\_\_ g.p.m. with \_\_\_\_\_ feet drawdown.  
\_\_\_\_\_ g.p.m. with \_\_\_\_\_ feet drawdown.

Date of test None

If Flowing Well: Measured discharge \_\_\_\_\_ g.p.m. on \_\_\_\_\_  
(Date)

Shut-in pressure at ground surface \_\_\_\_\_ lbs. per sq. in. on \_\_\_\_\_  
(Date)

Water is controlled by \_\_\_\_\_  
(Cap, valve, etc.)

8. Casing: (Give diameter, commercial specifications and depth below ground surface of each casing size.)

2 <sup>1</sup>/<sub>2</sub> inch diameter ..... from 0 to 2.0 feet  
..... inch diameter ..... from ..... to ..... feet  
..... inch diameter ..... from ..... to ..... feet  
..... inch diameter ..... from ..... to ..... feet

Describe and show depth of shoe, plug, adapter, liner or other details: .....

9. Perforated Casings or Screens:

Perforated ..... from 18 to 20  
(Number per foot and size of perforations, or describe screen.)  
..... from ..... to .....  
..... from ..... to .....  
..... from ..... to .....

10. Log of Well: (Describe each stratum or formation clearly, indicate if water bearing, and give thickness and depth as indicated.)

MATERIAL	Thickness (Feet)	Depth to Bottom (Feet)
None		

If log of well is not available, give name and address of driller. OWNER

11. Infiltration Trench: Covered or open .....

Dimensions: Length ..... ft. Minimum depth ..... ft. Maximum depth ..... ft.

Bottom width ..... ft. Discharge ..... g.p.m. Date of test .....

12. Tunnel: Type of lining .....

Dimensions: .....  
(Length, course, and cross sectional size)

Position of water bearing stratum with reference to portal of tunnel .....

Log of tunnel: (Preceding table for log of well may be used, if desired. Give footage from portal and character of materials, as pertinent.)

13. Pumping Equipment:

(a) Pump Gould Cent 2" x 2 1/2" Capacity 144 g.p.m.  
(Make, type and size)


(b) Motor 2 1/4 HP ELEC  
(Type and horsepower)

14. Location of area irrigated or to be irrigated, or place of use if for purposes other than irrigation.

Township North or South	Range E. or W. of Willamette Meridian	Section	Forty-acre Tract	Number Acres To Be Irrigated	Date of Reclamation
T17S	R4W	1	<del>SW 1/4</del>	<del>5.0</del>	1935
"	"	"	NW 1/4 of SW 1/4	2 1/2 Ac	"
"	"	"	NE 1/4 of SW 1/4	2 1/2 Ac	"
				5.0 Total	"

15. If the ground water supply is supplemental to an existing water supply, identification of any application for a permit, permit, certificate or adjudicated right to appropriate water made or held by the registrant.

Township 17.5 Range 4 W, W.M.  
North.

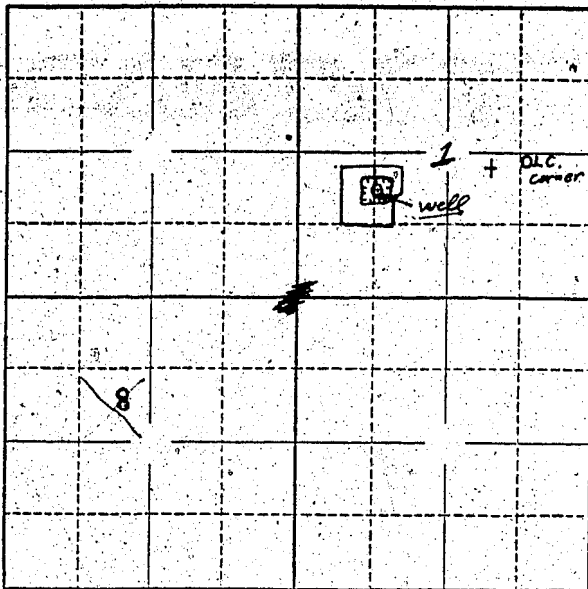

Locate well and acreage of irrigated land on plat.

Scale: 2" = 1 Mile

STATE OF OREGON

County of Tape } ss.

I, Ralph E. Clark, being first duly sworn, do hereby certify that I have read the foregoing Registration Statement and that all of the items therein contained are true to the best of my knowledge and belief.

Ralph E. Clark - Grace A. Clark  
(Signature of Registrant)

Subscribed and sworn to before me this 11 day of July, 1958

My commission expires Sept 29, 1958

D. G. Young  
(Notary Public)

(SEAL)

**CERTIFICATE OF REGISTRATION**

STATE OF OREGON

County of Marion } ss.

This is to certify that the foregoing Registration Statement was received in the office of the State Engineer on the 14 day of July, 1958, at 8:00 o'clock A. M. and has been duly recorded in said office in Book No. 16 of Registration Statements on page GR-3893

Witness my hand this 15<sup>th</sup> day of February, 1960

Lewis A. Stanley  
(State Engineer)

By \_\_\_\_\_

(Deputy)

GR 3893

\$15.00