

Registration Statement

OF CLAIMANT OF RIGHT TO APPROPRIATE GROUND WATER

TO THE STATE ENGINEER OF OREGON:

I, Robert L. Lealos
of Box 96 Just City County of Lane
State of Oregon, do hereby make application for a certificate of registration as evidence
of a right to appropriate ground water.

1. Source from which water is withdrawn is Pump well
(Flowing well, pump well, infiltration trench or tunnel)
2. Location is: about 4 miles north Just City
(Approximate distance and direction from nearest city or town)

and is more particularly described as follows:

(a) 500' N & 300' W from SE CORNER Sec 7
(Give distance and bearing to corner of section or other legal subdivision)
being within SE/SE of Sec. 7, Twp. 15 S, Rge. 4 W
(Smallest legal subdivision) (N. or S.) (E. or W.)

or (b) within limits of recorded platted property, town or city:
in Lot _____, Block _____ of _____
(Name of plat or addition)
County of _____
(If within city or town, give name)

3. Construction Work was begun on 1943; was completed on 1943
(Date) (Date)
and the ground water claimed was first used for the purposes set out below on 1943
since which time the water has been used intermittently
(Continuously or intermittently)
from June 1 to Oct 30
(Date) (Date)

4. Quantity of water claimed and used is 300 gallons per minute; 58 acre
feet per year.

5. Purpose or Purposes for which water is used irrigation
(Domestic, irrigation, municipal, manufacturing, industrial, etc.)

6. Description of Well: Depth 20 feet. Type Drilled DRIVEN
(Dug or drilled)
diameter 5 inches. Elevation of ground at well site 300 feet, mean sea level.
(As near as known)
Depth to water table 8 feet.

7. Capacity of Well: _____ g.p.m. with _____ feet drawdown.
_____ g.p.m. with _____ feet drawdown.


Date of test No

If Flowing Well: Measured discharge _____ g.p.m. on _____
(Date)

Shut-in pressure at ground surface _____ lbs. per sq. in. on _____
(Date)

Water is controlled by _____
(Cap, valve, etc.)

Township 15S Range 4W W.M.
North

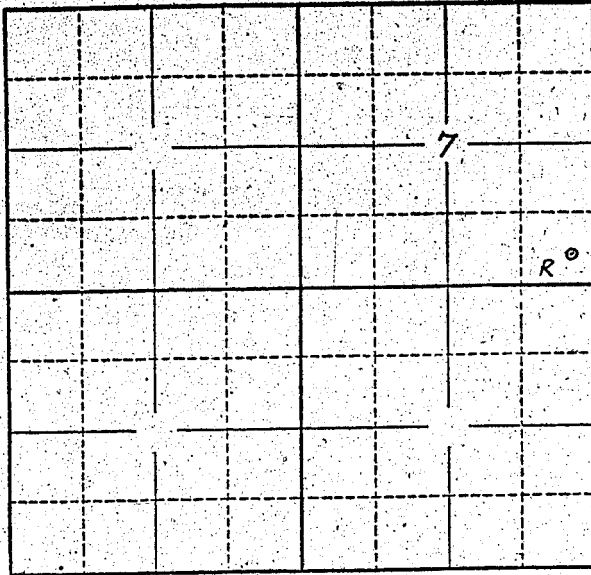

Locate well and acreage of irrigated land on plat.
Scale: 2" = 1 Mile

STATE OF OREGON

County of Linn } ss.

I, Robert L. Leabo, being first duly sworn, do hereby certify that I have read the foregoing Registration Statement and that all of the items therein contained are true to the best of my knowledge and belief.

Robert L. Leabo
(Signature of Registrant)

Subscribed and sworn to before me this 18th day of July, 19 58

My commission expires August 13, 1958 James W. Cook
(Notary Public)

(SEAL)

CERTIFICATE OF REGISTRATION

STATE OF OREGON

County of Marion } ss.

This is to certify that the foregoing Registration Statement was received in the office of the State Engineer on the 14 day of July, 1958, at 8:00 o'clock A. M. and has been duly recorded in said office in Book No. 9 of Registration Statements on page GR-2048

Witness my hand this 16th day of February, 1959

Lewis A. Stanley
(State Engineer)

By _____
(Deputy)

\$1500