

RECEIVED
JUL 14 1949
STATE ENGINEER
SALEM, OREGON

Registration No. GR. 2136
Certificate No. GR. 2049

Registration Statement

OF CLAIMANT OF RIGHT TO APPROPRIATE GROUND WATER

TO THE STATE ENGINEER OF OREGON:

I, Anton Reinholtz

of 55 River Ave County of Lane

State of Oregon, do hereby make application for a certificate of registration as evidence of a right to appropriate ground water.

1. Source from which water is withdrawn is Pump Well
(Flowing well, pump well, infiltration trench, or tunnel)

2. Location is: 3 miles North of Eugene on River Rd.
(Approximate distance and direction from nearest city or town)

and is more particularly described as follows: 1000 ft. S. & 75 ft. east from NW Cor. Sec. 13.

(a) 699.44 ft. South 11 1/4° East & North 81° East 26.23 ft. From
(Give distance and bearing to corner of section or other legal subdivision)
being within N.W. Corner of Lot A, Potters Survey # 686
(Smallest legal subdivision) of Sec 13, Twp. 17 S., Rge. 4 W.
(N. or S.) (E. or W.)

or (b) within limits of recorded platted property, town or city: Lane County
in Lot A, Block — of Potters Survey # 686
(Name of plat or addition)

County of Lane
(If within city or town, give name)

3. Construction Work was begun on May 10 1949, was completed on May 16 1949
(Date) (Date)

and the ground water claimed was first used for the purposes set out below on May 16 1949
(Date)

since which time the water has been used Continuously
(Continuously or intermittently)

from May 16 1949 to Present
(Date) (Date)

4. Quantity of water claimed and used is 1250 at 10 gals each gallons per minute; 9 acre feet per year.

5. Purpose or Purposes for which water is used To irrigate Shrubbery fruit & shade trees of a grower - Nurseryman
(Domestic, irrigation, municipal, manufacturing, industrial, etc.)

6. Description of Well: Depth 24 feet. Type 2 manifolded 2 1/2" driven
(Dug or drilled)
diameter 2 1/2" inches. Elevation of ground at well site 700 ft feet, mean sea level.
(As near as known)

Depth to water table 12 feet.

7. Capacity of Well: 1200 g.p.m. with 5 feet drawdown.


Approximate g.p.m. with 5 HP Capacity at 30 lbs feet drawdown. Pressure
Date of test No test made

If Flowing Well: Measured discharge _____ g.p.m. on _____
(Date)

Shut-in pressure at ground surface _____ lbs. per sq. in. on _____
(Date)

Water is controlled by _____
(Cap. valve, etc.)

Township 17S Range 4 West W.M.
11 North 12

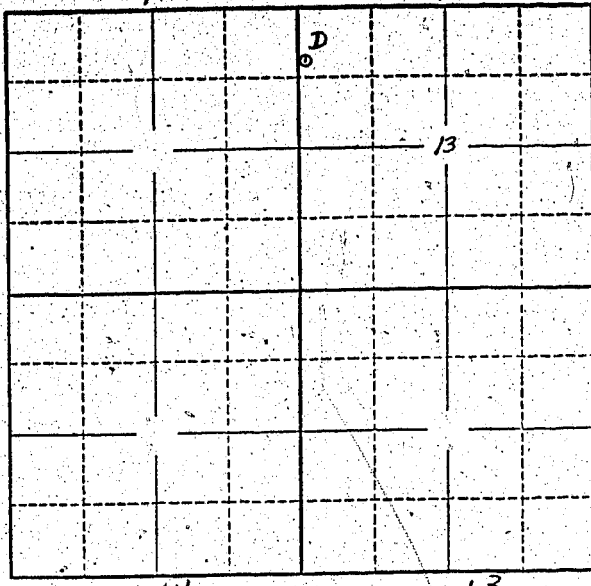

Locate well and acreage of irrigated land on plat.
Scale: 2" = 1 Mile

STATE OF OREGON

County of Lane } ss.

I, Anton Reinholz, being first duly sworn, do hereby certify that I have read the foregoing Registration Statement and that all of the items therein contained are true to the best of my knowledge and belief.

Anton Reinholz
(Signature of Registrant)

Subscribed and sworn to before me this 8th day of July, 1958

My commission expires Feb 11, 1961

Wm. G. Gray
(Notary Public)

(SEAL)

CERTIFICATE OF REGISTRATION

STATE OF OREGON

County of Marion } ss.

This is to certify that the foregoing Registration Statement was received in the office of the State Engineer on the 14th day of July, 1958, at 1.00 o'clock P.M. and has been duly recorded in said office in Book No. 9 of Registration Statements on page GR-2049

Witness my hand this 16th day of February, 1959

Levin A. Stanley
(State Engineer)

By _____
(Deputy)

\$1500