REGISTRATION NO. GR-214

CERTIFICATE NO. GR-199

Registration Statement

OF CLAIMANT OF RIGHT TO APPROPRIATE GROUND WATER

(Under Chapter 708, Oregon Laws 1955.)

TO THE STATE ENGINEER OF OREGON:

I, [illegible] of St. Paul County of Marion State of Oregon, do hereby make application for a certificate of registration as evidence of a right to appropriate ground water.

1. **Source** from which water is withdrawn is Well #1 "Graham well" (Flowing well, pump well, infiltration trench, or tunnel)

2. **Location** is: 3 Miles west of St Paul (Approximate distance and direction from nearest city or town);

and is more particularly described as follows:

(a) Approximately 2450 ft East and 1050 ft N of SW corner section 14 (Give distance and bearing to corner of section or other legal subdivision)

being within SE¼ SW¼ (Smallest legal subdivision) of Sec. 14, Twp. 4S (N. or S.), Rge. 3W (E. or W.)

or (b) within limits of recorded platted property, town or city: _____

in Lot _____, Block _____ of _____ (Name of plat or addition)

_____ (If within city or town, give name) County of _____

3. **Construction Work** was begun on ~~June~~ Feb 19 ~~27~~ 1951 (Date); was completed on June 27 1951 (Date)

and the ground water claimed was first used for the purposes set out below on Summer 1951 (Date),

since which time the water has been used Continuously during Irrigation Season (Continuously or intermittently)

from 1951 (Date) to 1956 (Date)

4. **Quantity** of water claimed and used is 210 gallons per minute; _____ acre feet per year.

5. **Purpose or Purposes** for which water is used Irrigation

_____ (Domestic, irrigation, municipal, manufacturing, industrial, etc.)

6. **Description of Well:** Depth 60 feet. Type Drilled (Dug or drilled)

diameter 10 inches. Elevation of ground at well site — (As near as known) feet, mean sea level.

Depth to water table 25 feet. May 1, 1956

7. **Capacity of Well:** 280 g.p.m. with ? feet drawdown.

_____ g.p.m. with _____ feet drawdown.

Date of test 1951

If Flowing Well: Measured discharge _____ g.p.m. on _____ (Date)

Shut-in pressure at ground surface _____ lbs. per sq. in. on _____ (Date)

Water is controlled by _____ (Cap, valve, etc.)

8. **Casing:** (Give diameter, commercial specifications and depth below ground surface of each casing size.)

10 inch diameter ..... from 0 to 55 feet

..... inch diameter ..... from ..... to ..... feet

..... inch diameter ..... from ..... to ..... feet

..... inch diameter ..... from ..... to ..... feet

Describe and show depth of shoe, plug, adapter, liner or other details: .....

9. **Perforated Casings or Screens:**

Perforated from 46 to 55
(Number per foot and size of perforations, or describe screen)

..... from ..... to .....

..... from ..... to .....

..... from ..... to .....

10. **Log of Well:** (Describe each stratum or formation clearly, indicate if water bearing, and give thickness and depth as indicated.)

MATERIAL	Thickness (Feet)	Depth to Bottom (Feet)
Loam		
Clay		
Gravel		

GR-199 A

If log of well is not available, give name and address of driller. J. E. Miller, Aurora

11. **Infiltration Trench:** Covered or open .....

Dimensions: Length ..... ft. Minimum depth ..... ft. Maximum depth ..... ft.

Bottom Width ..... ft. Discharge ..... g.p.m. Date of test .....

12. **Tunnel:** Type of lining .....

Dimensions: .....
(Length, course, and cross sectional size)

Position of water bearing stratum with reference to portal of tunnel .....

Log of tunnel: (Preceding table for log of well may be used, if desired. Give footage from portal and character of materials, as pertinent.)

13. **Pumping Equipment:**

(a) Pump Turbine (Fairbank Morse) Capacity 350 ? g.p.m.
(Make, type and size)

(b) Motor 15 HP
(Type and horsepower)

14. Location of area irrigated or to be irrigated, or place of use if for purposes other than irrigation.

Township North or South	Range E. or W. of Willamette Meridian	Section	Forty-acre Tract	Number Acres To Be Irrigated	Date of Reclamation
4 S	3 W	14	SE¼ SW¼	8	1951
			SW¼ SE¼	8	
				16	

15. If the ground water supply is supplemental to an existing water supply, identification of any application for a permit, permit, certificate or adjudicated right to appropriate water made or held by the registrant.

.....

GR-199 B

Sec 14 Township 4 S Range 3 W, W.M.

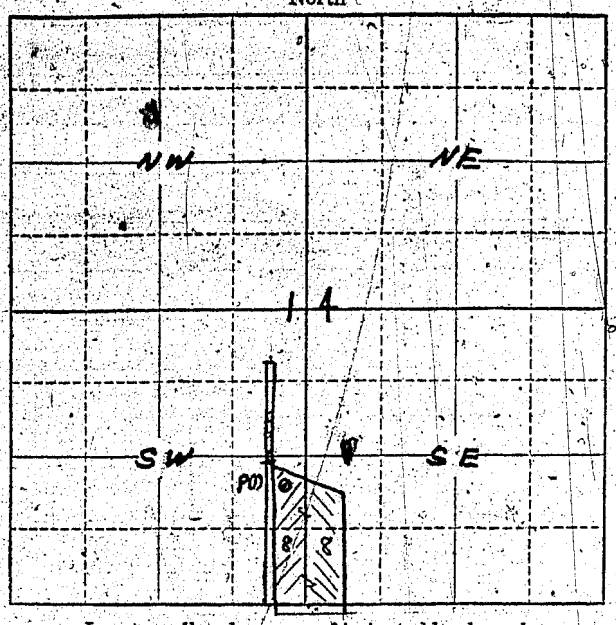

20 A
2 in SE 1/4 of SW 1/4
+
2 in SW 1/4 of SE 1/4

Locate well and acreage of irrigated land on plat.

Scale: 2" = 1 Mile

STATE OF OREGON
County of Marion } ss.

I, Mary B. Brosnan, being first duly sworn, do hereby certify that I have read the foregoing Registration Statement and that all of the items therein contained are true to the best of my knowledge and belief.

Mary B. Brosnan
(Signature of Registrant)

Subscribed and sworn to before me this 27th day of July, 1956.

My commission expires Sept. 8, 1956 Clio L. Seibler
(Notary Public)

(SEAL)

CERTIFICATE OF REGISTRATION

STATE OF OREGON
County of Marion } ss.

This is to certify that the foregoing Registration Statement was received in the office of the State Engineer on the 27th day of July, 1956, at 8 o'clock A.M. and has been duly recorded in said office in Book No. 1 of Registration Statements on page GR-199 C

~~Construction shall be completed by x-x-x-x-x-x-x-x-x-19x-x, and the water completely applied to beneficial use by x-x-x-x-x-x-x-x-x-x-19x-x.~~

Witness my hand this 23rd day of November, 1956.

Lewis A. Stanley
(State Engineer)

By
(Deputy)

GR-199C