

Registration Statement

OF CLAIMANT OF RIGHT TO APPROPRIATE GROUND WATER

TO THE STATE ENGINEER OF OREGON:

I, A. P. Howells
of Route 4, Box 181, Albany County of Benton
(Mailing address)
State of Oregon do hereby make application for a certificate of registration as evidence of a right to appropriate ground water.

1. Source from which water is withdrawn is pump well
(Flowing well, pump well, infiltration trench, or tunnel)
2. Location is: 2 miles NW of Albany
(Approximate distance and direction from nearest city or town)

and is more particularly described as follows:

(a) S 58° W 4.65 chains to 1/4 section corner, Sec. 35, 36, T. 10S, R. 1W, well
(Give distance and bearing to corner of section or other legal subdivision)
being within SW 1/4 SE 1/4 of Sec. 36, Twp. 10S, Rge. 1W
(Smallest legal subdivision) (N. or S.) (E. or W.)
or (b) within limits of recorded platted property, town or city:
in Lot , Block of
(Name of plat or addition)
County of
(If within city or town, give name)

3. Construction Work was begun on 1916; was completed on 1916
(Date) (Date)
and the ground water claimed was first used for the purposes set out below on 1916
(Date)
since which time the water has been used continuously
(Continuously or intermittently)
from 1916 to 1958
(Date) (Date)

4. Quantity of water claimed and used is 10 gallons per minute; 5 acre feet per year.

5. Purpose or Purposes for which water is used irrigation
(Domestic, irrigation, municipal, manufacturing, industrial, etc.)


6. Description of Well: Depth 185 feet. Type drilled
(Dug or drilled)
diameter 6 inches. Elevation of ground at well site 230 feet, mean sea level.
(As near as known)
Depth to water table 25 feet.

7. Capacity of Well: 10 g.p.m. with 20 feet drawdown.
 g.p.m. with feet drawdown.

Date of test 1916
If Flowing Well: Measured discharge g.p.m. on
(Date)
Shut-in pressure at ground surface lbs. per sq. in. on
(Date)
Water is controlled by
(Cap, valve, etc.)

Township 10.5 Range 4W, W.M.

North

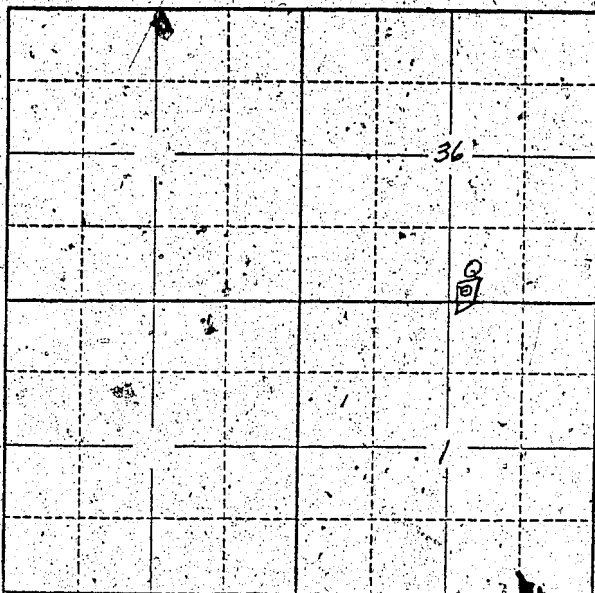

Locate well and acreage of irrigated land on plat.

Scale: 2" = 1 Mile

STATE OF OREGON

County of Marion

ss.

I, _____, being first duly sworn, do hereby certify that I have read the foregoing Registration Statement and that all of the items therein contained are true to the best of my knowledge and belief.

x D. A. P. Howells
(Signature of Registrant)

Subscribed and sworn to before me this 15th day of July, 1958

My commission expires 12th June 1961

Wm. S. Balthazars
(Notary Public)

(SEAL)

CERTIFICATE OF REGISTRATION

STATE OF OREGON

County of Marion

ss.

This is to certify that the foregoing Registration Statement was received in the office of the State Engineer on the 15th day of July, 1958, at 8:00 o'clock A.M. and has been duly recorded in said office in Book No. 16 of Registration Statements on page GR-3858

Witness my hand this 28th day of December, 1959

Laura A. Stanley
(State Engineer)

By _____

(Deputy)

GR 3858