

Registration Statement

OF CLAIMANT OF RIGHT TO APPROPRIATE GROUND WATER

TO THE STATE ENGINEER OF OREGON:

I, Washington County Home
of 27280 S.W. Tualatin V. Hwy County of Washington
(Mailing address)

State of Oregon do hereby make application for a certificate of registration as evidence of a right to appropriate ground water.

1. Source from which water is withdrawn is Pump Well
(Flowing well, pump well, infiltration trench, or tunnel)

2. Location is: 1 mile East of Hillsboro, Oregon
(Approximate distance and direction from nearest city or town)

and is more particularly described as follows:

(a) 2225' N. & 315' S of NE corner of Sec 8 T1S R2W
(Give distance and bearing to corner of section or other legal subdivision)

being within NW 1/4 & NE 1/4 of Sec. 8, Twp. 1S, Rge. 2W
(Specify legal subdivisions) (N. or S.) (E. or W.)

or (b) within limits of recorded platted property, town or city:

in Lot _____, Block _____ of _____
(Name of plat or addition)

County of _____
(If within city or town, give name)

3. Construction Work was begun on 1928; was completed on 1928
(Date) (Date)

and the ground water claimed was first used for the purposes set out below on 1928
(Date)

since which time the water has been used CONTINUOUSLY
(Continuously or Intermittently)

from 1928 to 1958
(Date) (Date)

4. Quantity of water claimed and used is 40 gallons per minute; 30 acre feet per year.

5. Purpose or Purposes for which water is used irrigation

(Domestic, irrigation, municipal, manufacturing, industrial, etc.)

6. Description of Well: Depth 200 feet. Type drilled
(Dug or drilled)

diameter 8 inches. Elevation of ground at well site 225 feet, mean sea level.
(As near as known)

Depth to water table 35 feet.

7. Capacity of Well: 40 g.p.m. with 115 feet drawdown.

_____ g.p.m. with _____ feet drawdown.

Date of test July 1957

If-Flowing Well: Measured discharge _____ g.p.m. on _____
(Date)

Shut-in pressure at ground surface _____ lbs. per sq. in. on _____
(Date)

Water is controlled by _____
(Cap, valve, etc.)

8. Casing: (Give diameter, commercial specifications and depth below ground surface of each casing size.)

8 inch diameter from GS to 200 feet

inch diameter from to feet

inch diameter from to feet

inch diameter from to feet

Describe and show depth of shoe, plug, adapter, liner or other details:

9. Perforated Casings or Screens:

..... from to

(Number per foot and size of perforations, or describe screen)

..... from to

..... from to

..... from to

10. Log of Well: (Describe each stratum or formation clearly, indicate if water bearing, and give thickness and depth as indicated.)

MATERIAL	Thickness (Feet)	Depth to Bottom (Feet)

If log of well is not available, give name and address of driller: A. M. JANNSEN

21076 SW Tualatin Valley Hwy, Aloha, Oregon

11. Infiltration Trench: Covered or open

Dimensions: Length _____ ft. Minimum depth _____ ft. Maximum depth _____ ft.

Bottom width _____ ft. Discharge _____ g.p.m. Date of test _____

12. Tunnel: Type of lining _____

Dimensions: _____
(Length, course, and cross sectional size)

Position of water bearing stratum with reference to portal of tunnel _____

Log of tunnel: (Preceding table for log of well may be used, if desired. Give footage from portal and character of materials, as pertinent.)

13. Pumping Equipment:

(a) Pump Meyers deep Well Jet Capacity 40 g.p.m.
(Make, type and size)


(b) Motor 3HP Electric
(Type and horsepower)

14. Location of area irrigated or to be irrigated, or place of use if for purposes other than irrigation.

Township North or South	Range E. or W. of Williamsite Meridian	Section	Forty-acre Tract	Number Acres To Be Irrigated	Date of Reclamation
1 S	2 W	8	NW 1/4 of NE 1/4	120	1928

15. If the ground water supply is supplemental to an existing water supply, identification of any application for a permit, permit, certificate or adjudicated right to appropriate water made or held by the registrant.

Township 1 S Range 2 W, W.M.
North

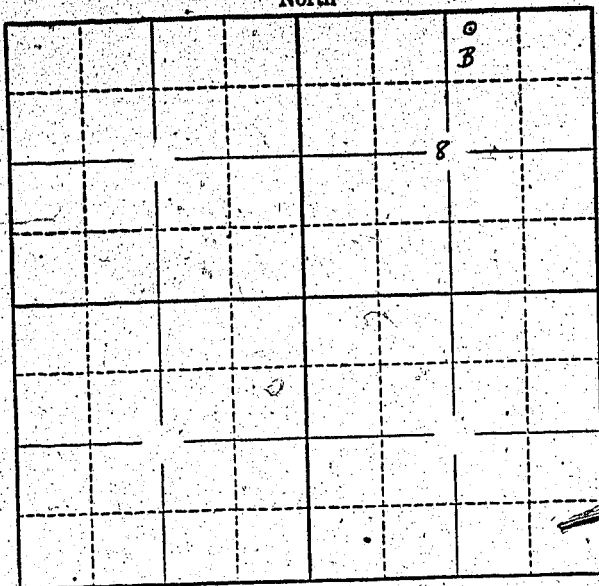

Locate well and acreage of irrigated land on plat.
Scale: 2" = 1 Mile

STATE OF OREGON

County of Washington

ss.

I, Washington County, being first duly sworn, do hereby certify that I have read the foregoing Registration Statement and that all of the items therein contained are true to the best of my knowledge and belief.

Hook Co.

Walter H. Johnson
(Signature of Registrant)

Subscribed and sworn to before me this 11 day of July, 1958

My commission expires Sept 24, 1958

George C. Shoop
(Notary Public)

(SEAL)

NOTARY PUBLIC FOR OREGON
My Commission Expires Sept. 24, 1958

CERTIFICATE OF REGISTRATION

STATE OF OREGON

County of Marion

ss.

This is to certify that the foregoing Registration Statement was received in the office of the State Engineer on the 15th day of July, 1958, at 8:00 o'clock A.M. and has been duly recorded in said office in Book No. 9 of Registration Statements on page GR 2056

Witness my hand this 16th day of February, 1959

Lewis A. Stanley
(State Engineer)

By

(Deputy)

\$15.00

GR - 2056