



Registration No. GR-2148

Certificate No. GR 2060

# Registration Statement

## OF CLAIMANT OF RIGHT TO APPROPRIATE GROUND WATER

TO THE STATE ENGINEER OF OREGON:

I, A.W. Peters  
of Rt. 2 Box 249 Forest Grove County of Washington  
(Mailing address)

State of Oregon, do hereby make application for a certificate of registration as evidence of a right to appropriate ground water.

1. Source from which water is withdrawn is pump well  
(Flowing well, pump well, infiltration trench, or tunnel)

2. Location is: 1 mile SW. of Roy on Reeling road  
(Approximate distance and direction from nearest city or town)

and is more particularly described as follows:

(a) 2,630 ft. S17°0'E from NW corner Sec. 8  
(Give distance and bearing to corner of section or other legal subdivision)

being within SW 1/4 of NW 1/4 of Sec. 8, Twp. 1N, Rge. 3W  
(Smallest legal subdivision) (N. or S.) (E. or W.)

or (b) within limits of recorded platted property, town or city:

in Lot \_\_\_\_\_, Block \_\_\_\_\_ of \_\_\_\_\_  
(Name of plat or addition)

County of \_\_\_\_\_  
(If within city or town, give name)

3. Construction Work was begun on Early 1930; was completed on same year  
(Date) (Date)

and the ground water claimed was first used for the purposes set out below on same year  
(Date)

since which time the water has been used Continuously  
(Continuously or intermittently)

from 1953 to 1958  
(Date) (Date)

4. Quantity of water claimed and used is 18 gallons per minute; 12.5 acre feet per year.

5. Purpose or Purposes for which water is used Irrigation

(Domestic, irrigation, municipal, manufacturing, industrial, etc.)

6. Description of Well: Depth 965 feet. Type drilled  
(Dug or drilled)

diameter 4 inches. Elevation of ground at well site 200 feet; mean sea level.  
(As near as known)

Depth to water table 8 feet.

7. Capacity of Well: 17 g.p.m. with 30 feet drawdown.

\_\_\_\_\_ g.p.m. with \_\_\_\_\_ feet drawdown.

Date of test none made

If Flowing Well: Measured discharge \_\_\_\_\_ g.p.m. on \_\_\_\_\_  
(Date)


Shut-in pressure at ground surface \_\_\_\_\_ lbs. per sq. in. on \_\_\_\_\_  
(Date)

Water is controlled by \_\_\_\_\_  
(Cap, valve, etc.)





Township 1N Range 3W, W.M.  
North

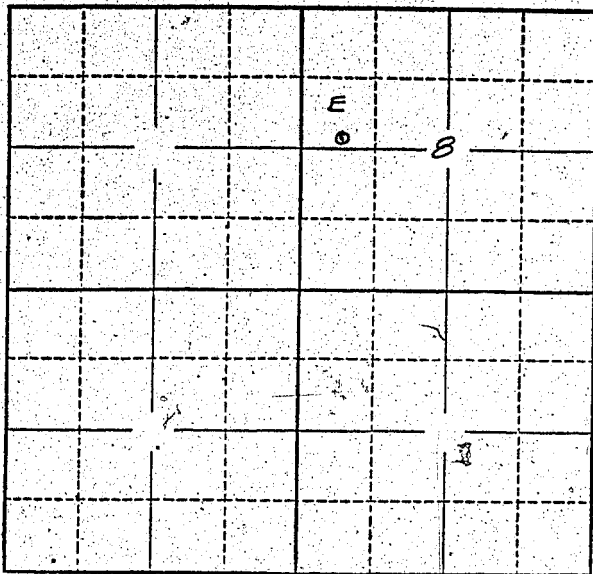

Locate well and acreage of irrigated land on plat.  
Scale: 2" = 1 Mile

STATE OF OREGON

County of Marion } ss.

I, A. W. Peters, being first duly sworn, do hereby certify that I have read the foregoing Registration Statement and that all of the items therein contained are true to the best of my knowledge and belief.

A. W. Peters  
(Signature of Registrant)

Subscribed and sworn to before me this 7th day of July, 19 58

My commission expires 12th June 1961 Wm. S. Bartholomew  
(Notary Public)

(SEAL)

**CERTIFICATE OF REGISTRATION**

STATE OF OREGON

County of Marion } ss.

This is to certify that the foregoing Registration Statement was received in the office of the State Engineer on the 15th day of July, 19 58, at 9:30 o'clock A. M. and has been duly recorded in said office in Book No. 9 of Registration Statements on page 2060

Witness my hand this 16th day of February, 19 59

Lewis A. Stanley  
(State Engineer)

By \_\_\_\_\_  
(Deputy)

GR 2060

4/500