

Registration Statement

OF CLAIMANT OF RIGHT TO APPROPRIATE GROUND WATER

(Under Chapter 708, Oregon Laws 1955.)

TO THE STATE ENGINEER OF OREGON:

I, Jessamine Cherry, 4658 Macley Rd.
of Salem County of Marion

State of Oregon, do hereby make application for a certificate of registration as evidence of a right to appropriate ground water.

1. Source from which water is withdrawn is Pump well
(Flowing well, pump well, infiltration trench, or tunnel)
2. Location is: Approx 3 1/2 miles South East of Salem
(Approximate distance and direction from nearest city or town)

and is more particularly described as follows:

- (a) 900 ft East and 600 ft. North from SW corner section 32
(Give distance and bearing to corner of section or other legal subdivision)
being within SW 1/4 of SW 1/4 of Sec. 32 Twp. 7S Rge. 2E 2W.
(Smallest legal subdivision) (N. or S.) (E. or W.)
or (b) within limits of recorded platted property, town or city:
in Lot _____ Block _____ of _____
(Name of plat or addition)

County of _____
(If within city or town, give name)

3. Construction Work was begun on Aug 1 - 1950 ; was completed on Sept 15 - 1950
(Date) (Date)
and the ground water claimed was first used for the purposes set out below on June 1951
(Date)
since which time the water has been used intermittently
(Continuously or Intermittently)
from June 1951 to present time
(Date) (Date)

4. Quantity of water claimed and used is 40 gallons per minute; _____ acre
feet per year.

5. Purpose or Purposes for which water is used to irrigate 8 acres pasture
and 7 acres cultivated crops
(Domestic, irrigation, municipal, manufacturing, industrial, etc.)

6. Description of Well: Depth 22 feet. Type dug
(dug or drilled)
diameter 33 inches. Elevation of ground at well site _____ feet, mean sea level.
(As near as known)
Depth to water table 10 ft in fall of the year

7. Capacity of Well: 40 g.p.m. with 20 feet drawdown. in June
g.p.m. with _____ feet drawdown.

Date of test estimate during irrigation (June 1956)

If Flowing Well: Measured discharge _____ g.p.m. on _____
(Date)

Shut-in pressure at ground surface _____ lbs. per sq. in. on _____
(Date)

Water is controlled by _____
(Cap, valve, etc.)

33 inch diameter from 1 ft to 22 feet
12 inch diameter from 0 ft to 1 ft
inch diameter from to feet
inch diameter from to feet

Describe and show depth of shoe, plug, adapter, liner or other details: *There are 7 well tiles 3 ft long plus 1 ft of 12" tile to top of ground for a total of 22 ft deep.*

9. Perforated Casings or Screens:

(Number per foot and size of perforations, or describe screen)	from	to
	from	to
	from	to
	from	to

10. Log of Well: (Describe each stratum or formation clearly, indicate if water bearing, and give thickness and depth as indicated.)

[illegible]

If log of well is not available, give name and address of driller. _____

11. Infiltration Trench: Covered or open

Dimensions: Length ft. Minimum depth ft. Maximum depth ft.

Bottom width ft. Discharge g.p.m. Date of test

12. Tunnel: Type of lining

Dimensions: _____
(Length, course, and cross sectional size)

Position of water bearing stratum with reference to portal of tunnel

Log of tunnel: (Preceding table for log of well may be used, if desired. Give footage from portal and character of materials, as pertinent.)

13. Bumping Equipment:

(a) Pump Mayer Centrifugal Capacity 40 g.p.m.

(b) Motor, 4 horsepower Wisconsin gasoline
(Type and horsepower)


14. Location of area irrigated or to be irrigated, or place of use if for purposes other than irrigation.

[illegible]

15. If the ground water supply is supplemental to an existing water supply, identification of any application for a permit, permit, certificate or adjudicated right to appropriate water made or held by the registrant.

GR-201B

Township 7S Range 2W, W.M.
North

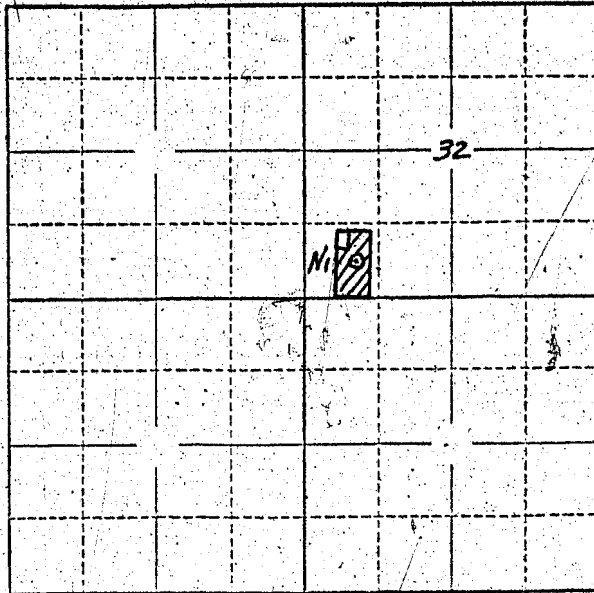

Locate well and acreage of irrigated land on plat.

Scale: 2" = 1 Mile

STATE OF OREGON

County of Marion

★.SS.

I, Jerimima Cherry, being first duly sworn, do hereby certify that I have read the foregoing Registration Statement and that all of the items therein contained are true to the best of my knowledge and belief.

Jerimira Chenay
(Signature of Registrant)

(Signature of Registrant)

Subscribed and sworn to before me this 28 day of July, 1956

My commission expires March 4, 1958

Attest:
Notary Public

INTEGRITY PUBLIC

(SEAL)

CERTIFICATE OF REGISTRATION

STATE OF OREGON

County of Marion

SS:

This is to certify that the foregoing Registration Statement was received in the office of the State Engineer on the 1st day of August, 1956, at 10 o'clock A.M. and has been duly recorded in said office in Book No. 2 of Registration Statements on page GR-201 C.

Construction shall be completed by ~~xxxxxx~~ 19xx and the system completely applied to
beneficial use by ~~xxxxxx~~ 19xx.

Witness my hand this 23rd day of November

19.56

1956
Lewis A. Stanley
(State Engineer)

(State Engineer

By

(Deputy)

GR-201 C