

Registration Statement

OF CLAIMANT OF RIGHT TO APPROPRIATE GROUND WATER

TO THE STATE ENGINEER OF OREGON:

1. Paul A Smith

of Aurora A 2 Box 8 3 County of Clatsop

State of Ore, do hereby make application for a certificate of registration as evidence of a right to appropriate ground water.

1. Source from which water is withdrawn is Well #1
(Flowing well, pump well, infiltration trench, or tunnel)

2. Location is: 1 mile East of Aurora
(Approximate distance and direction from nearest city or town)

and is more particularly described as follows:

(a) 1650 feet east & 890 feet south from NW corner Section 18
(Give distance and bearing to corner of section or other legal subdivision)

being within NE 1/4 of NW 1/4 of Sec. 18, Twp. 4S, Rge. 1E
(Smallest legal subdivision) (T. or S.) (R. or 20-)

or (b) within limits of recorded platted property, town or city:

in Lot _____, Block _____ of _____
(Name of plat or addition)

County of _____
(If within city or town, give name)

3. Construction Work was begun on March 10 - 1950, was completed on March 25 - 1950
(Date) (Date)

and the ground water claimed was first used for the purposes set out below on April 1 - 1950
(Date)

since which time the water has been used Continuously, intermittently during season
(Continuously or intermittently)

from April 1950 to Oct. 1957
(Date) (Date)

4. Quantity of water claimed and used is 100 gallons per minute; _____ acre feet per year.

5. Purpose or Purposes for which water is used Irrigation

6. Description of Well: Depth 70 feet. Type Drilled
(Dug or drilled)

diameter 6 inches. Elevation of ground at well site _____ feet, mean sea level.
(As near as known)

Depth to water table 15 feet.

7. Capacity of Well: 150 g.p.m. with 28 feet drawdown.

_____ g.p.m. with _____ feet drawdown.

Date of test April 1, 1950

If Flowing Well: Measured discharge _____ g.p.m. on _____
(Date)

Shut-in pressure at ground surface _____ lbs. per sq. in. on _____
(Date)

Water is controlled by _____
(Cap, valve, etc.)

8. Casing: (Give diameter, commercial specifications and depth below ground surface of each casing size.)


6 inch diameter steel casing from 0 to 70 feet
 inch diameter from to feet
 inch diameter from to feet
 inch diameter from to feet

Describe and show depth of shoe, plug, adapter, liner or other details:

9. Perforated Casings or Screens:

yes Torch cut slots from 58 to 70
(Number per foot and size of perforations, or describe screen)
 from to
 from to
 from to

10. Log of Well: (Describe each stratum or formation clearly, indicate if water bearing, and give thickness and depth as indicated.)

MATERIAL	Thickness (Feet)	Depth to Bottom (Feet)
sand ✓	0	69
gravel	69	70
		

If log of well is not available, give name and address of driller. Cook & Coleman

11. Infiltration Trench: Covered or open

Dimensions: Length ft. Minimum depth ft. Maximum depth ft.

Bottom width ft. Discharge g.p.m. Date of test

12. Tunnel: Type of lining

Dimensions:
(Length, course, and cross sectional size)

Position of water bearing stratum with reference to portal of tunnel

Log of tunnel: (Preceding table for log of well may be used, if desired. Give footage from portal and character of materials, as pertinent.)

13. Pumping Equipment:

(a) Pump Fairbank Morse 4 in Capacity 150 g.p.m.
(Make, type and size)


(b) Motor Flechl 3-Horse
(Type and horsepower)

14. Location of area irrigated or to be irrigated, or place of use if for purposes other than irrigation.

Township North or South	Range E. or W. of Willamette Meridian	Section	Forty-acre Tract	Number Acres To Be Irrigated	Date of Reclamation
T4S	R1E	28	NE 1/4 of NW 1/4	5.26	1950

15. If the ground water supply is supplemental to an existing water supply, identification of any application for a permit, permit, certificate or adjudicated right to appropriate water made or held by the registrant.

Township 45 Range 1E W.M.
North

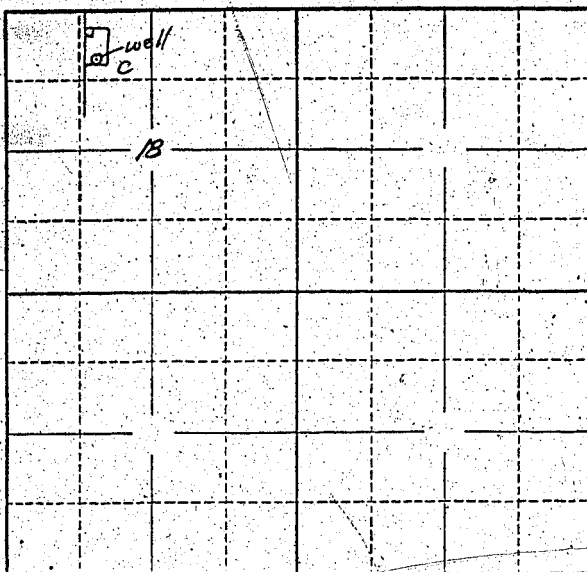

Locate well and acreage of irrigated land on plat.

Scale: 2" = 1 Mile

STATE OF OREGON

County of Marion } ss.

I, Paul A. Smith, being first duly sworn, do hereby certify that I have read the foregoing Registration Statement and that all of the items therein contained are true to the best of my knowledge and belief.

Paul A. Smith
(Signature of Registrant)

Subscribed and sworn to before me this 15th day of July, 1958

My commission expires 12th June 1961 Wm. S. Bartholomew
(Notary Public)

(SEAL)

CERTIFICATE OF REGISTRATION

STATE OF OREGON

County of Marion } ss.

This is to certify that the foregoing Registration Statement was received in the office of the State Engineer on the 15th day of July, 1958, at 11:30 o'clock A. M. and has been duly recorded in said office in Book No. 9 of Registration Statements on page GR 2070

Witness my hand this 16th day of February, 1959

Lewis A. Stender
(State Engineer)

\$15.00

By _____ (Deputy)