

# Registration Statement

REGISTRATION NO. GR-2161  
CERTIFICATE NO. GR-2071

## OF CLAIMANT OF RIGHT TO APPROPRIATE GROUND WATER

(Under Chapter 708, Oregon Laws 1955.)

### TO THE STATE ENGINEER OF OREGON:

I, Raymond P. Smith, Secretary-Treasurer of the St. Paul Cemetary Association  
of St. Paul, County of Marion

State of Oregon, do hereby make application for a certificate of registration as evidence of a right to appropriate ground water.

1. Source from which water is withdrawn is Pump Well  
(Flowing well, pump well, infiltration trench, or tunnel)

2. Location is: Adjacent to the East boundary of the City Of St. Paul, Oregon.  
(Approximate distance and direction from nearest city or town)

and is more particularly described as follows:

(a) 2400' S & 250' W from NE Corner Section 19  
(Give distance and bearing to corner of section or other legal subdivision)

being within SE 1/4 NE 1/4 of Sec. 19, Twp. 4 S, Rge. 2 W  
(Smallest legal subdivision) (N. or S.) (E. or W.)

or (b) within limits of recorded platted property, town or city:

in Lot \_\_\_\_\_, Block \_\_\_\_\_ of \_\_\_\_\_  
(Name of plat or addition)

County of \_\_\_\_\_  
(If within city or town, give name)

3. Construction Work was begun on April 22, 1949; was completed on May 17, 1949  
(Date) (Date)

and the ground water claimed was first used for the purposes set out below on May 17, 1949  
(Date)

since which time the water has been used continuously (during lawn irrigation season)  
(Continuously or intermittently)

from May 17, 1949 to July 15, 1958  
(Date) (Date)

4. Quantity of water claimed and used is 80 gallons per minute; 11 acre  
feet per year.

5. Purpose or Purposes for which water is used To irrigate cemetary lawn.

(Domestic, irrigation, municipal, manufacturing, industrial, etc.)

6. Description of Well: Depth 125 feet Type Drilled  
(Dug or drilled)

diameter 6 inches. Elevation of ground at well site 169 feet, mean sea level.  
(As near as known)

Depth to water table 32 feet. (Static)  
dd. to

7. Capacity of Well: 80 g.p.m. with 90 feet drawdown.

\_\_\_\_\_ g.p.m. with \_\_\_\_\_ feet drawdown.

Date of test May 17, 1949

If Flowing Well: Measured discharge \_\_\_\_\_ g.p.m. on \_\_\_\_\_  
(Date)

Shut-in pressure at ground surface \_\_\_\_\_ lbs. per sq. in. on \_\_\_\_\_  
(Date)

Water is controlled by \_\_\_\_\_  
(Cap, valve, etc.)

8. Casing: (Give diameter, commercial specifications and depth below ground surface of each casing size.)

6 inch diameter ..... from 0 ..... to 124 feet  
 ..... inch diameter ..... from ..... to ..... feet  
 ..... inch diameter ..... from ..... to ..... feet  
 ..... inch diameter ..... from ..... to ..... feet

Describe and show depth of shoe, plug, adapter, liner or other details: None

9. Perforated Casings or Screens:


None ..... from ..... to .....  
 (Number per foot and size of perforations, or describe screen)  
 ..... from ..... to .....  
 ..... from ..... to .....  
 ..... from ..... to .....

10. Log of Well: (Describe each stratum or formation clearly, indicate if water bearing, and give thickness and depth as indicated.)

MATERIAL	Thickness (Feet)	Depth to Bottom (Feet)
Surface	3	0 - 3 feet
Surface Clay	21	3 - 23 feet
Surface Sand, water	4	23 - 27 feet
Yellow Clay	32	27 - 59 feet
Grey Clay	50	59 - 109 feet
Blue Clay	5	109 - 114 feet
Black Sand	7	114 - 121 feet
Small Gravel & Sand	4	121- 125 feet
Pipe drove to 124 feet. Drilled to 125 feet.		
Static water level 32 feet.		
Well was not test pumped.		
Well pumped with permanent pump.		
Tested 80 GPM at 90 ft. draw down.		



Township 45 Range 2W W.M.  
North

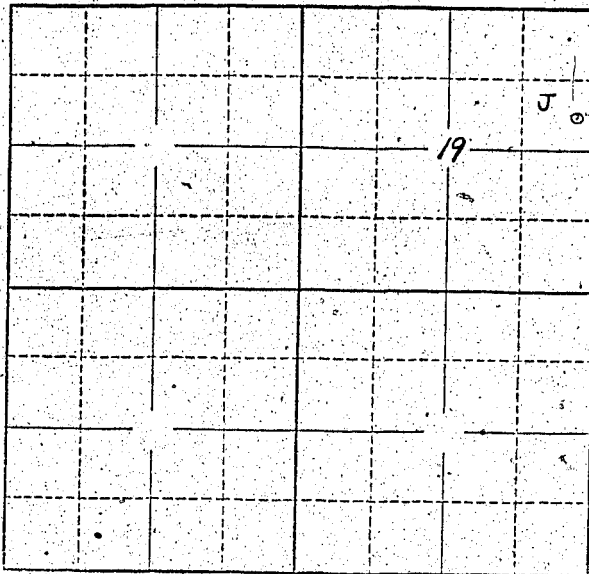

Locate well and acreage of irrigated land on plat.  
Scale: 2" = 1 Mile

STATE OF OREGON

County of Marion } ss.

I, Raymond P. Smith, Sec-Treas of the St. Paul Cemetary Association, being first duly sworn, do hereby certify that I have read the foregoing Registration Statement and that all of the items therein contained are true to the best of my knowledge and belief.

by Raymond P. Smith  
(Signature of Registrant) Sec-Treas.

Subscribed and sworn to before me this 15th day of July, 1958.

My commission expires 12th June 1961 Wm. S. Bartholomew  
(Notary Public)

(SEAL)

**CERTIFICATE OF REGISTRATION**

STATE OF OREGON } ss.  
County of Marion

This is to certify that the foregoing Registration Statement was received in the office of the State Engineer on the 15th day of July, 1958, at 10:00 o'clock A.M. and has been duly recorded in said office in Book No. 9 of Registration Statements on page GR-207.

Witness my hand this 16th day of February, 1959.

Lawrence A. Stanley  
(State Engineer)

By \_\_\_\_\_ (Deputy)

15.00

GR-207