

Registration Statement

OF CLAIMANT OF RIGHT TO APPROPRIATE GROUND WATER

TO THE STATE ENGINEER OF OREGON:

I, WILLIAM F. WATSON
of P.O. Box 60 TURNER County of MARION
(Mailing address)
State of OREGON, do hereby make application for a certificate of registration as evidence of a right to appropriate ground water.

- 1. Source from which water is withdrawn is PUMP WELL
(Flowing well, pump well, infiltration trench, or tunnel)
- 2. Location is: 1 1/4 mi NE Marion
(Approximate distance and direction from nearest city or town)

and is more particularly described as follows:

(a) 660' E 95.7' N of 1/4 corner on West line of Sec 27
(Give distance and bearing to corner of section or other legal subdivision)
being within SW 1/4 of NW 1/4 of Sec. 27, Twp. 9S, Rge. 2W
(Smallest legal subdivision) (N. or S.) (E. or W.)

or (b) within limits of recorded platted property, town or city:
in Lot _____, Block _____ of _____
(Name of plat or addition)
County of _____
(If within city or town, give name)

3. Construction Work was begun on AUG 1, 1952; was completed on AUG 1, 1952
(Date) (Date)
and the ground water claimed was first used for the purposes set out below on AUG 1, 1952
(Date)
since which time the water has been used INTERMITTENTLY
(Continuously or intermittently)
from AUG 1, 1952 to SEPT 1, 1957
(Date) (Date)

4. Quantity of water claimed and used is 80 gallons per minute; 36 acre feet per year.

5. Purpose or Purposes for which water is used IRRIGATION

6. Description of Well: Depth 16 feet. Type SUMP
(Domestic, irrigation, municipal, manufacturing, industrial, etc.) (Dug or drilled)
diameter 10' x 20' inches. Elevation of ground at well site _____ feet, mean sea level.
(As near as known)
Depth to water table 0' feet. (Top of ground)

7. Capacity of Well: _____ g.p.m. with _____ feet drawdown.
_____ g.p.m. with _____ feet drawdown.

Date of test During Irrig., will empty in 6 hours at 80 gpm flow

If Flowing Well: Measured discharge _____ g.p.m. on _____
(Date)

Shut-in pressure at ground surface _____ lbs. per sq. in. on _____
(Date)

Water is controlled by _____
(Cap. valve, etc.)

8. Casing: (Give diameter, commercial specifications and depth below ground surface of each casing size.)

No Casing

..... inch diameter from to feet
..... inch diameter from to feet
..... inch diameter from to feet
..... inch diameter from to feet

Describe and show depth of shoe, plug, adapter, liner or other details:

.....

.....

9. Perforated Casings or Screens:

..... from to
(Number per foot and size of perforations, or describe screen)

No

..... from to
..... from to
..... from to

10. Log of Well: (Describe each stratum or formation clearly, indicate if water bearing, and give thickness and depth as indicated.)

MATERIAL	Thickness (Feet)	Depth to Bottom (Feet)
gravel & blue mud mixture	16'	16

If log of well is not available, give name and address of driller.

11. Infiltration Trench: Covered or open open
 Dimensions: Length 20 ft. Minimum depth ft. Maximum depth 16 ft.
 Bottom width 10 ft. Discharge g.p.m. Date of test

12. Tunnel: Type of lining
 Dimensions:
(Length, course, and cross sectional size)
 Position of water bearing stratum with reference to portal of tunnel

Log of tunnel: (Preceding table for log of well may be used; if desired. Give footage from portal and character of materials, as pertinent.)

13. Pumping Equipment:


(a) Pump Pacific Centrifugal Capacity about 180 g.p.m.
(Make, type and size)
 (b) Motor 12 HP John Deere gas stationary
(Type and horsepower)

14. Location of area irrigated or to be irrigated, or place of use if for purposes other than irrigation.

Township North or South	Range E. or W. of Willamette Meridian	Section	Forty-acre Tract	Number Acres To Be Irrigated	Date of Reclamation
<u>9S</u>	<u>2W</u>	<u>27</u>	<u>SW/1/4</u>	<u>10.5</u>	<u>1952</u>
<u>"</u>	<u>"</u>	<u>28</u>	<u>SE/1/4</u>	<u>3.8</u>	<u>1952</u>
				<u>14.3 Ac</u>	

15. If the ground water supply is supplemental to an existing water supply, identification of any application for a permit, permit, certificate or adjudicated right to appropriate water made or held by the registrant.

Township 9S Range 2W, W.M.
North

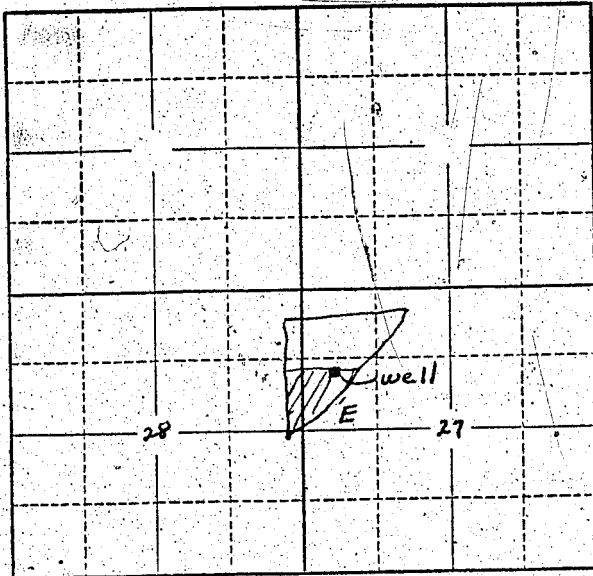

Locate well and acreage of irrigated land on plat.
Scale: 2" = 1 Mile

STATE OF OREGON

County of William H. Watson } ss.

I, _____, being first duly sworn, do hereby certify that I have read the foregoing Registration Statement and that all of the items therein contained are true to the best of my knowledge and belief.

William H. Watson
(Signature of Registrant)

Subscribed and sworn to before me this 15th day of July, 1958.

My commission expires 12th June 1961

Wm. S. Bartholomew
(Notary Public)

(SEAL)

CERTIFICATE OF REGISTRATION

STATE OF OREGON

County of Marion } ss.

This is to certify that the foregoing Registration Statement was received in the office of the State Engineer on the 15th day of July, 1958, at 11:45 o'clock A. M. and has been duly recorded in said office in Book No. 9 of Registration Statements on page GR-2072

Witness my hand this 16th day of February, 1959

Laura A. Stanley
(State Engineer)

By _____ (Deputy)

\$15.00