

Registration Statement

OF CLAIMANT OF RIGHT TO APPROPRIATE GROUND WATER

TO THE STATE ENGINEER OF OREGON:

I, Kenneth W. Miller

of 3315 River Bend Road, Salem County of Polk
(Mailing address)

State of Oregon, do hereby make application for a certificate of registration as evidence of a right to appropriate ground water.

1. Source from which water is withdrawn is Pump, sump hole
(Flowing well, pump well, infiltration trench, or tunnel)

2. Location is: 3 miles northwest of Salem
(Approximate distance and direction from nearest city or town)

and is more particularly described as follows: Beginning at NW corner of sec 10

thence east 2600 feet along sec. line, thence
(a) South 820 feet to sump hole
(Give distance and bearing to corner of other legal subdivision)

being within NE 1/4 of NW 1/4 of Sec. 10, Twp. 7 S, Rge. 3 W
(Smallest legal subdivision) (N. or S.) (E. or W.)

or (b) within limits of recorded platted property, town or city:

in Lot _____, Block _____ of _____
(Names of plat or addition)

County of _____
(If within city or town, give name)

3. Construction Work was begun on May 1953; was completed on June 1955
(Date) (Date)

and the ground water claimed was first used for the purposes set out below on July 1955
(Date)

since which time the water has been used intermittently
(Continuously or intermittently)

from July 1955 to present time
(Date) (Date)

4. Quantity of water claimed and used is 300 gallons per minute; 50 acre feet per year.

5. Purpose or Purposes for which water is used Irrigation

(Domestic, irrigation, municipal, manufacturing, industrial, etc.)

6. Description of Well: Depth _____ feet. Type _____
(Dug or drilled)

diameter _____ inches. Elevation of ground at well site 128 feet, mean sea level.
(As near as known)

Depth to water table 13 feet.

7. Capacity of Well: _____ g.p.m. with _____ feet drawdown.

_____ g.p.m. with _____ feet drawdown.

Date of test _____

If Flowing Well: Measured discharge _____ g.p.m. on _____
(Date)

Shut-in pressure at ground surface _____ lbs. per sq. in. on _____
(Date)

Water is controlled by _____
(Cap, valve, etc.)

8. Casing: (Give diameter, commercial specifications and depth below ground surface of each casing size.)

..... inch diameter from to feet

..... inch diameter from to feet

..... inch diameter from to feet

..... inch diameter from to feet

Describe and show depth of shoe, plug, adapter, liner or other details:

.....

.....

9. Perforated Casings or Screens:

..... from to

(Number per foot and size of perforations, or describe screen)

..... from to

..... from to

..... from to

10. Log of Well: (Describe each stratum or formation clearly, indicate if water bearing, and give thickness and depth as indicated.)

MATERIAL	Thickness (Feet)	Depth to Bottom (Feet)
Gravel	25	25

If log of well is not available, give name and address of driller. _____

11. Infiltration Trench: Covered or open open

Dimensions: Length 80 ft. Minimum depth 10 ft. Maximum depth 25 ft.

Bottom width 4 ft. Discharge 325 g.p.m. Date of test July 1955

12. Tunnel: Type of lining _____

Dimensions: _____
(Length, course, and cross sectional size)

Position of water bearing stratum with reference to portal of tunnel _____

Log of tunnel: (Preceding table for log of well may be used, if desired. Give footage from portal and character of materials, as pertinent.)

13. Pumping Equipment:

(a) Pump Cornell, model 2 1/2 W-15 Capacity 400 g.p.m.
(Make, type and size)


(b) Motor GE electric, 3 phase 15 H.P., speed 34.80
(Type and horsepower)

14. Location of area irrigated or to be irrigated, or place of use if for purposes other than irrigation.

Township North or South	Range E. or W. of Willamette Meridian	Section	Forty-acre Tract	Number Acres To Be Irrigated	Date of Reclamation
75	3 W	10	NW 1/4 NW 1/4	61.0	July, 1955
75	2 W	10	SW 1/4 NW 1/4	3.2	" "
75	3 W	10	SE 1/4 NW 1/4	5.2	" "
75	3 W	10	NE 1/4 NW 1/4	9.6	" "
				24.0	

15. If the ground water supply is supplemental to an existing water supply, identification of any application for a permit, permit, certificate or adjudicated right to appropriate water made or held by the registrant.

Township 7S Range 3W, W.M.
North

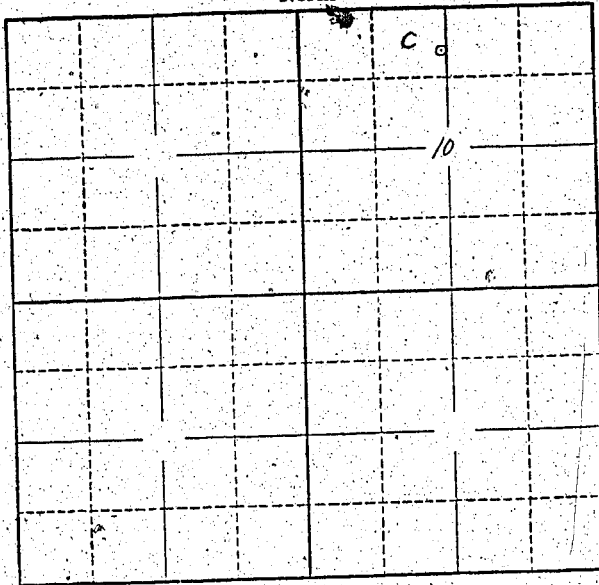

Locate well and acreage of irrigated land on plat.
Scale: 2" = 1 Mile

STATE OF OREGON

County of Marion } ss.

I, Kenneth W. Miller, being first duly sworn, do hereby certify that I have read the foregoing Registration Statement and that all of the items therein contained are true to the best of my knowledge and belief.

Kenneth W. Miller
(Signature of Registrant)

Subscribed and sworn to before me this 15th day of July, 1958

My commission expires 12th June 1961

Wm. S. Bartholomew
(Notary Public)

(SEAL)

CERTIFICATE OF REGISTRATION

STATE OF OREGON

County of Marion } ss.

This is to certify that the foregoing Registration Statement was received in the office of the State Engineer on the 15th day of July, 1958, at 1:20 o'clock P. M. and has been duly recorded in said office in Book No. 9 of Registration Statements on page GR-2076

Witness my hand this 16th day of February, 1959

Lawrence A. Stovall
(State Engineer)

By _____ (Deputy)

GR-2076

#15.00