

# Registration Statement

## OF CLAIMANT OF RIGHT TO APPROPRIATE GROUND WATER

TO THE STATE ENGINEER OF OREGON:

I, P. M. SPIRUP

of Star R<sup>o</sup> Box 25 St Paul, Oregon County of MARION

State of Oregon, do hereby make application for a certificate of registration as evidence of a right to appropriate ground water.

1. Source from which water is withdrawn is Pump Well  
(Flowing well, pump well, infiltration trench, or tunnel)

2. Location is: 1 MILE SOUTH & 1 MILE EAST FROM ST. PAUL, ORE  
(Approximate distance and direction from nearest city or town)

and is more particularly described as follows:

(a) WELLS 2100' N. & 200' W. FROM SE CORNER SECTION 30  
(Give distance and bearing to corner of section or other legal subdivision)

being within T. 41 N. R. 14 E. S. 34 of Sec 30, T. 48 N. W. 2 W. R. 14 E., Rge. 2 W.  
(Smallest legal subdivision) (N. or S.) (E. or W.)

or (b) within limits of recorded platted property, town or city:

in Lot \_\_\_\_\_, Block \_\_\_\_\_ of \_\_\_\_\_  
(Name of plat or addition)

County of \_\_\_\_\_  
(If within city or town, give name)

3. Construction Work was begun on Feb. 1955; was completed on March 1955  
(Date) (Date)

and the ground water claimed was first used for the purposes set out below on May 1955  
(Date)

since which time the water has been used intermittently during season  
(Continuously or intermittently)

from May 1955 to Oct 1957  
(Date) (Date)

4. Quantity of water claimed and used is 300 gallons per minute; \_\_\_\_\_ acre feet per year.

5. Purpose or Purposes for which water is used DOMESTIC, IRRIGATION

(Domestic, irrigation, municipal, manufacturing, industrial, etc.)

6. Description of Well: Depth 224 feet. Type DRILLED  
(Dug or drilled)

diameter 16 inches. Elevation of ground at well site \_\_\_\_\_ feet, mean sea level.

Depth to water table 23 feet.  
STATIC LEVEL (As near as known)

7. Capacity of Well: 380 g.p.m. with 60 feet drawdown.

600 g.p.m. with 72 feet drawdown.

Date of test \_\_\_\_\_

If Flowing Well: Measured discharge \_\_\_\_\_ g.p.m. on \_\_\_\_\_  
(Date)

Shut-in pressure at ground surface \_\_\_\_\_ lbs. per sq. in. on \_\_\_\_\_  
(Date)

Water is controlled by \_\_\_\_\_  
(Cap, valve, etc.)

8. Casing: (Give diameter, commercial specifications and depth below ground surface of each casing size.)

16 inch diameter PIPE NO PERFORATED from 0 to 120 feet  
 10 inch diameter from 120 to 128 feet  
 inch diameter from to feet  
 inch diameter from to feet

Describe and show depth of shoe, plug, adapter, liner or other details:

9. Perforated Casings or Screens:

SET 120 FT. IN. IN. PIPE NO PERFORATED from to  
(Number per foot and size of perforations, or describe screen)  
 SET 78 FT. OF 10 IN. PIPE PERFORATED from 128 to 130  
 AND ~~PIPE~~ PERFORATED from 157 to 165  
 GRAVELED PACKED AND PUMPED TOOLS from to  
 10 YARDS GRAVEL

10. Log of Well: (Describe each stratum or formation clearly, indicate if water bearing, and give thickness and depth as indicated.)

MATERIAL	Thickness (Feet)	Depth to Bottom (Feet)
SURFACE	0-5	
GREY CLAY	5-20	
GREY SAND (WATER)	20-24	
BLUE CLAY	24-40	
GREY CLAY	40-76	
BLACK SAND (WATER)	76-78	
BLUE CLAY	78-115	
BLACK SANDY CLAY (SILT)	115-90	
BLUE CLAY	90-122	
RED SANDY MUDDY	122-130	
BLUE CLAY	130-157	
BLACK SAND (WATER)	157-165	
BLUE CLAY	165-220	
COURSE BROWN SAND AND GRAVEL	220-224	224

If log of well not available, give name and address of driller.

11. Infiltration Trench: Covered or open

Dimensions: Length ..... ft. Minimum depth ..... ft. Maximum depth ..... ft.

Bottom width ..... ft. Discharge ..... g.p.m. Date of test .....

12. Tunnel: Type of lining

Dimensions: .....  
(Length, course, and cross sectional size)

Position of water bearing stratum with reference to portal of tunnel .....

Log of tunnel: (Preceding table for log of well may be used, if desired. Give footage from portal and character of materials, as pertinent.)

13. Pumping Equipment:

(a) Pump *30WELL P 22*  
*JACUZZI TURBINE B.H.P. 2.3 HP* Capacity ..... *300* g.p.m.  
(Make, type and size)

(b) Motor *VERTICAL HOLLOW SHAFT MOTOR NON-REVERSE ROTATION 3*  
*PHASE 1750 RPM 220 VOLTS 60 CYCLES 1.10'S S.P.M. BORE BASE DIAMETER*  
*1 1/2 IN. MAKE U.S. H.P. 20*  
(Type and horsepower)


14. Location of area irrigated or to be irrigated, or place of use if for purposes other than irrigation.

Township North or South	Range E. or W. of Willamette Meridian	Section	Forty-acre Tract	Number Acres To Be Irrigated	Date of Reclamation
48	2W	30	SE 1/4 NE 1/4	15.0	MAY-1955
"	"	"	NE 1/4 SE 1/4	15.0	" "
"	"	"	SE 1/4 SE 1/4	15.0	" "
"	"	29	SW 1/4 NW 1/4	18.0	" "
"	"	"	NW 1/4 SW 1/4	20.0	" "
"	"	"	SW 1/4 SW 1/4	20.0	" "
"	"	32	NW 1/4 NW 1/4	7.0	" "
"	"	31	WE 1/4 WE 1/4	9.0	" "
				109.0	" "

15. If the ground water supply is supplemental to an existing water supply, identification of any application for a permit, permit, certificate or adjudicated right to appropriate water made or held by the registrant.

*None*

Township 4S Range 2W W.M.  
North

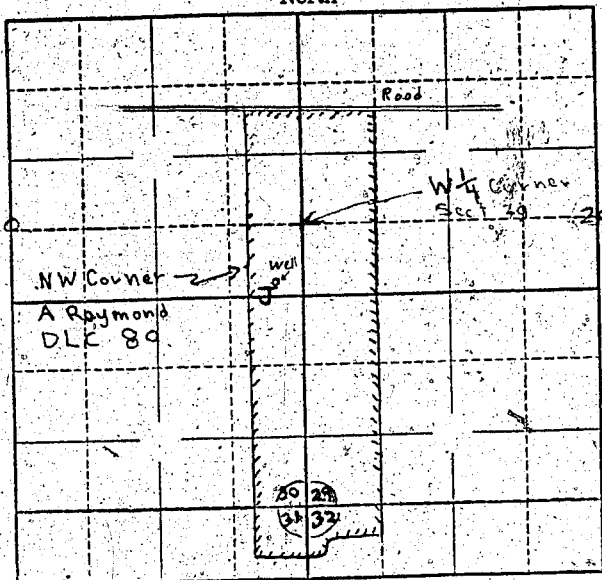

Locate well and acreage of irrigated land on plat.

Scale:  $\frac{2''}{4''} = 1$  Mile

STATE OF OREGON

County of Marion } ss.

I, \_\_\_\_\_, being first duly sworn, do hereby certify that I have read the foregoing Registration Statement and that all of the items therein contained are true to the best of my knowledge and belief.

P. Lee Spierup  
(Signature of Registrant)

Subscribed and sworn to before me this 2nd day of April, 1958.

My commission expires 12th June 1961

Wm. S. Bartholomew  
(Notary Public)

(SEAL)

**CERTIFICATE OF REGISTRATION**

STATE OF OREGON

County of Marion } ss.

This is to certify that the foregoing Registration Statement was received in the office of the State Engineer on the 15th day of July, 1958, at 2:00 o'clock P. M. and has been duly recorded in said office in Book No. 9 of Registration Statements on page GR-208!

Witness my hand this 16th day of February, 1959.

Lucretia A. Stander  
(State Engineer)

By \_\_\_\_\_ (Deputy)

\$ 26.45

GR - 208!