

# Registration Statement

REGISTRATION NO. GR-2176  
CERTIFICATE NO. GR-2085

## OF CLAIMANT OF RIGHT TO APPROPRIATE GROUND WATER

(Under Chapter 708, Oregon Laws 1955.)

TO THE STATE ENGINEER OF OREGON:

I, THEL F. NEVILLE  
of CORVALLIS Rt. 4 Box 364A County of BENTON

State of OREGON, do hereby make application for a certificate of registration as evidence of a right to appropriate ground water.

- Source from which water is withdrawn is PUMP Well #1  
(Flowing well, pump well, infiltration trench, or tunnel)
- Location is: 5 miles S.E. CORVALLIS OREGON  
(Approximate distance and direction from nearest city or town)

and is more particularly described as follows:

(a) 3431.09 SOUTH 538.42 EAST FROM NORTH WEST CORNER SECTION 18  
(Give distance and bearing to corner of section or other legal subdivision)  
being within SW QUARTER of NW 1/4 of Sec. 18, Twp. 12S, Rge. 4W  
(Smallest legal subdivision) (N. or S.) (E. or W.)

or (b) within limits of recorded platted property, town or city:

in Lot \_\_\_\_\_, Block \_\_\_\_\_ of \_\_\_\_\_  
(Name of plat or addition)

\_\_\_\_\_ County of \_\_\_\_\_  
(If within city or town, give name)

- Construction Work was begun on May 3, 1953; was completed on MAY 8, 1953  
(Date) (Date)

and the ground water claimed was first used for the purposes set out below on JUNE 1953  
(Date)

since which time the water has been used CONTINUOUSLY - DURING IRRIGATION SEASON  
(Continuously or intermittently)

from JUNE 1953 to JULY 1958  
(Date) (Date)

- Quantity of water claimed and used is 800 gallons per minute; 480 acre feet per year.

5. Purpose or Purposes for which water is used IRRIGATION

(Domestic, irrigation, municipal, manufacturing, industrial, etc.)

- Description of Well: Depth 31 feet. Type DRILLED  
(Dug or drilled)

diameter 12 inches. Elevation of ground at well site 370 feet, mean sea level.  
(As near-as known)

Depth to water table 30 feet.

- Capacity of Well: 800 g.p.m. with 3' 6" feet drawdown.  
\_\_\_\_\_ g.p.m. with \_\_\_\_\_ feet drawdown.

Date of test MAY 8 1953

If Flowing Well: Measured discharge \_\_\_\_\_ g.p.m. on \_\_\_\_\_  
(Date)

Shut-in pressure at ground surface \_\_\_\_\_ lbs. per sq. in. on \_\_\_\_\_  
(Date)

Water is controlled by \_\_\_\_\_  
(Cap, valve, etc.)

8. Casing: (Give diameter, commercial specifications and depth below ground surface of each casing size.)

12 inch diameter ..... from 0 to 31 feet  
 ..... inch diameter ..... from ..... to ..... feet  
 ..... inch diameter ..... from ..... to ..... feet  
 ..... inch diameter ..... from ..... to ..... feet

Describe and show depth of shoe, plug, adapter, liner or other details: .....

9. Perforated Casings or Screens:

7 # 10 Rows 1/2 x 6" Slots ..... from 0" to 7'  
(Number per foot and size of perforations, or describe screen)  
 ..... from ..... to .....  
 ..... from ..... to .....  
 ..... from ..... to .....

10. Log of Well: (Describe each stratum or formation clearly, indicate if water bearing, and give thickness and depth as indicated.)

MATERIAL	Thickness (Feet)	Depth to Bottom (Feet)
0-16 ft. Sand & Gravel	16	16
16-31 ft gravel coarse	15	31
Water at 20' - 31'	11	31
Water level 13' from ground	18	31
pumped 800 gal per min		
lowered water to 16' 6"		
drawdown 3' 6" pumping at 800 gal.		
Log in Well Record Book		

If log of well is not available, give name and address of driller. ....

**11. Infiltration Trench:** Covered or open .....

Dimensions: Length ..... ft. Minimum depth ..... ft. Maximum depth ..... ft.

Bottom width ..... ft. Discharge ..... g.p.m. Date of test .....

**12. Tunnel:** Type of lining .....

Dimensions: .....  
(Length, course, and cross sectional size)

Position of water bearing stratum with reference to portal of tunnel .....

Log of tunnel: (Preceding table for log of well may be used, if desired. Give footage from portal and character of materials, as pertinent.)

**13. Pumping Equipment:** 6x5 SPLIT CASE CENTRIFUGAL 800

(a) Pump FAIRBANKS MORSE CENTRIFUGAL 4K3 Capacity 480 g.p.m.  
(Make, type and size)


(b) Motor GENERAL ELECTRIC 3 5/8 HP  
(Type and horsepower)

**14. Location of area irrigated or to be irrigated, or place of use if for purposes other than irrigation.**

Township North or South	Range E. or W. of Willamette Meridian	Section	Forty-acre Tract	Number Acres To Be Irrigated	Date of Reclamation
12 S	4 W	18	SW 1/4 of NW 1/4	<del>31.3</del> 31.3	1937
12 S	4 W	18	NW 1/4 of SW 1/4	<del>31.3</del> 35.1	1952
12 S	4 W	18	SW 1/4 of SW 1/4	0.0	1952
12 S	4 W	18	NE 1/4 of SW 1/4	16.2	1954
12 S	4 W	18	NW 1/4 of SE 1/4	5.3	1954
				<b>Total 100.8 ac.</b>	
			50 HP PUMP INSTALLED DURING SUMMER 1958		

15. If the ground water supply is supplemental to an existing water supply, identification of any application for a permit, permit, certificate or adjudicated right to appropriate water made or held by the registrant.

Township 12S Range 4W, W.M.  
North

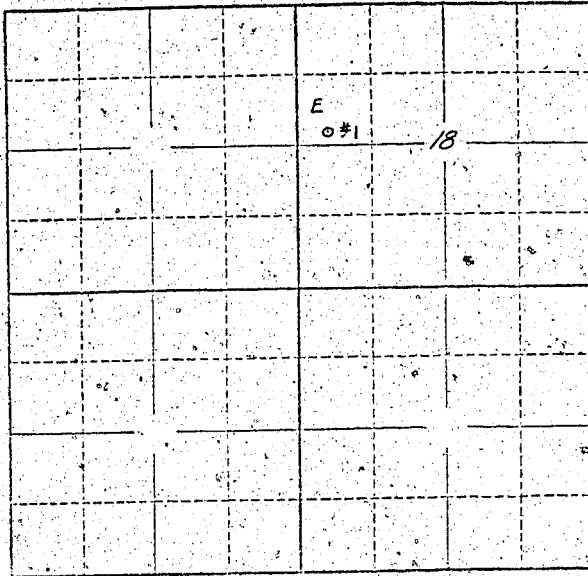

~~See map~~  
in application

Locate well and acreage of irrigated land on plat.  
Scale: 2" = 1 Mile

STATE OF OREGON

County of Marion

ss.

I, Therell F. Neville, being first duly sworn, do hereby certify that I have read the foregoing Registration Statement and that all of the items therein contained are true to the best of my knowledge and belief.

Therell F. Neville  
(Signature of Registrant)

Subscribed and sworn to before me this 15th day of July, 1958

My commission expires 12th June 1961

Wm. S. Bartholomew  
(Notary Public)

(SEAL)

### CERTIFICATE OF REGISTRATION

STATE OF OREGON

County of Marion

ss.

This is to certify that the foregoing Registration Statement was received in the office of the State Engineer on the 15th day of July, 1958, at 8:30 o'clock A. M. and has been duly recorded in said office in Book No. 9 of Registration Statements on page GR-2085

~~Construction shall be completed by \_\_\_\_\_ and the water complete applied tax~~  
~~herein shall be by \_\_\_\_\_~~

Witness my hand this 16th day of February, 1959

Lawrence A. [Signature]  
(State Engineer)

By \_\_\_\_\_ (Deputy)

GR-2085