

Registration Statement

OF CLAIMANT OF RIGHT TO APPROPRIATE GROUND WATER

TO THE STATE ENGINEER OF OREGON:

I, Therl F. Neville

of Corvallis ROUTE 4 BOX 364A County of BENTON

State of OREGON, do hereby make application for a certificate of registration as evidence of a right to appropriate ground water.

1. Source from which water is withdrawn is Pump Well #2
(Flowing well, pump well, infiltration trench, or tunnel)
2. Location is: 5 miles SE Corvallis Oregon
(Approximate distance and direction from nearest city or town)

and is more particularly described as follows:

(a) 1191.35 SOUTH 991.08 EAST FROM NORTHWEST CORNER OF SECTION 18
(Give distance and bearing to corner of section or other legal subdivision)
being within N 1/4 NW 1/4 of Sec. 18, Twp. 12 S, Rge. 4 W
(Smallest legal subdivision) (N. or S.) (E. or W.)

or (b) within limits of recorded platted property, town or city:

in Lot _____, Block _____ of _____
(Name of plat or addition)

County of _____
(If within city or town, give name)

3. Construction Work was begun on July 7, 1953, was completed on July 11, 1953
(Date) (Date)
and the ground water claimed was first used for the purposes set out below on July 1953
(Date)
since which time the water has been used: CONTINUOUSLY DURING IRRIGATION SEASON
(Continuously or intermittently)
from July 1953 to SEPT. 1957
(Date) (Date)

4. Quantity of water claimed and used is 350 gallons per minute; _____ acre feet per year.

5. Purpose or Purposes for which water is used IRRIGATION
(Domestic, irrigation, municipal, manufacturing, industrial, etc.)

6. Description of Well: Depth 30 feet. Type Drilled
(Dug or drilled)
diameter 10 inches. Elevation of ground at well site 360 feet, mean sea level.
(As near as known)
Depth to water table 20 feet.

7. Capacity of Well: 350 g.p.m. with _____ feet drawdown.
_____ g.p.m. with _____ feet drawdown.

Date of test _____

If Flowing Well: Measured discharge _____ g.p.m. on _____
(Date)

Shut-in pressure at ground surface _____ lbs. per sq. in. on _____
(Date)

Water is controlled by _____
(Cap, valve, etc.)

8. Casing: (Give diameter, commercial specifications and depth below ground surface of each casing size.)

10 inch diameter from to 27 feet
 inch diameter from to feet
 inch diameter from to feet
 inch diameter from to feet

Describe and show depth of shoe, plug, adapter, liner or other details:

9. Perforated Casings or Screens:

9 Rows 1/2" X 5" SLOTS from 0" to 8"
(Number per foot and size of perforations, or describe screen)
 from to
 from to
 from to

10. Log of Well: (Describe each stratum or formation clearly, indicate if water bearing, and give thickness and depth as indicated.)

MATERIAL	Thickness (Feet)	Depth to Bottom (Feet)
0-8 ft. loam	8	8
8-20 ft. Hard pan	12	20
20-27 ft. gravel carrying water	7	27
23-24 ft. big gravel	1	24
Log in Well Record Book		

If log of well is not available, give name and address of driller.

11. Infiltration Trench: Covered or open

Dimensions: Length ft. Minimum depth ft. Maximum depth ft.

Bottom width ft. Discharge g.p.m. Date of test

12. Tunnel: Type of lining

Dimensions:
(Length, course, and cross sectional size)

Position of water bearing stratum with reference to portal of tunnel

Log of tunnel: (Preceding table for log of well may be used, if desired. Give footage from portal and character of materials, as pertinent.)

13. Pumping Equipment:

(a) Pump DEMMING CENTRIFUGAL 3x2 Capacity 360 g.p.m.
(Make, type and size)

(b) Motor STERLING 15 HP
(Type and horsepower)


14. Location of area irrigated or to be irrigated, or place of use if for purposes other than irrigation.

Township North or South	Range E. or W. of Willamette Meridian	Section	Forty-acre Tract	Number Acres To Be Irrigated	Date of Reclamation
12 S	4 W	18	NW 1/4 NW 1/4	19.0	1953
12 S	4 W	18			
12 S	4 W	18			
12 S	4 W	18			

15. If the ground water supply is supplemental to an existing water supply, identification of any application for a permit, permit, certificate or adjudicated right to appropriate water made or held by the registrant.

Township 12S Range 4W, W.M.

North

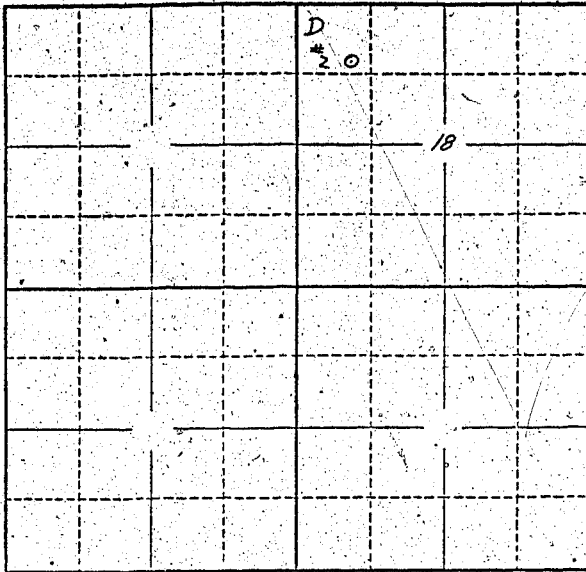

Locate well and acreage of irrigated land on plat.

Scale: 2" = 1 Mile

STATE OF OREGON

County of Marion } ss.

I, Theodore F. Neville, being first duly sworn, do hereby certify that I have read the foregoing Registration Statement and that all of the items therein contained are true to the best of my knowledge and belief.

Theodore F. Neville
(Signature of Registrant)

Subscribed and sworn to before me this 15th day of July, 1958

My commission expires 12th June 1961 Wm. S. Bartholomew
(Notary Public)

(SEAL)

CERTIFICATE OF REGISTRATION

STATE OF OREGON } ss.
County of Marion

This is to certify that the foregoing Registration Statement was received in the office of the State Engineer on the 15th day of July, 1958, at 8:30 o'clock A. M. and has been duly recorded in said office in Book No. 9 of Registration Statements on page GR-2086

Witness my hand this 16th day of February, 1959

Lewis A. Stanley
(State Engineer)

By _____
(Deputy)

\$15.00

GR - 2086