

Registration Statement

OF CLAIMANT OF RIGHT TO APPROPRIATE GROUND WATER

TO THE STATE ENGINEER OF OREGON:

I, Evelyn E. Hatch

of Rt 1 Box 95 Aumsville County of Marion

State of ORE do hereby make application for a certificate of registration as evidence of a right to appropriate ground water.

1. Source from which water is withdrawn is Pump Well #2
(Flowing well, pump well, infiltration trench, or tunnel)

2. Location is: 4 1/2 mi SW Stayton
(Approximate distance and direction from nearest city or town)

and is more particularly described as follows:

(a) 2013 ft. W. & 495 ft. N. from 1/4 corner on E. Line Sec. 19
(Give distance and bearing to corner of section or other legal subdivision)

being within SW/NE of Sec. 19, Twp. 9S Rge. 1W
(Smallest legal subdivision) (N. or S.) (E. or W.)

or (b) within limits of recorded platted property, town or city:

in Lot _____, Block _____ of _____
(Name of plat or addition)

(If within city or town, give name) _____ County of _____

3. Construction Work was begun on 1948; was completed on June 1956
(Date) (Date)

and the ground water claimed was first used for the purposes set out below on June 1948
(Date)

since which time the water has been used Intermittently
(Continuously or intermittently)

from June 1948 to Sept 1957
(Date) (Date)

4. Quantity of water claimed and used is 200 gallons per minute; 15 acre feet per year.

5. Purpose or Purposes for which water is used Irrigation

(Domestic, irrigation, municipal, manufacturing, industrial, etc.)

6. Description of Well: Depth 25 feet. Type DRILLED
(Dug or drilled)

diameter 8" inches. Elevation of ground at well site 275 feet, mean sea level.
(As near as known)

Depth to water table 15 feet.

7. Capacity of Well: 200 g.p.m. with 5 feet drawdown. (goes dry when neighbors pump)
_____ g.p.m. with _____ feet drawdown.

Date of test During Irrigation 1957

If Flowing Well: Measured discharge _____ g.p.m. on _____
(Date)

Shut-in pressure at ground surface _____ lbs. per sq. in. on _____
(Date)

Water is controlled by _____
(Cap, valve, etc.)

8. Casing: (Give diameter, commercial specifications and depth below ground surface of each casing size.)

8. inch diameter *SH* from 0 to 25 feet
..... inch diameter from to feet
..... inch diameter from to feet
..... inch diameter from to feet

Describe and show depth of shoe, plug, adapter, liner or other details:

9. Perforated Casings or Screens:

cut with Torch from 13 to 25'
(Number per foot and size of perforations, or describe screen)
..... from to
..... from to
..... from to

10. Log of Well: (Describe each stratum or formation clearly, indicate if water bearing, and give thickness and depth as indicated.)

MATERIAL	Thickness (Feet)	Depth to Bottom (Feet)
<i>Not available</i>		

If log of well is not available, give name and address of driller.

11. Infiltration Trench: Covered or open

Dimensions: Length ft. Minimum depth ft. Maximum depth ft.

Bottom width ft. Discharge g.p.m. Date of test

12. Tunnel: Type of lining

Dimensions:
(Length, course, and cross sectional size)

Position of water bearing stratum with reference to portal of tunnel

Log of tunnel: (Preceding table for log of well may be used, if desired. Give footage from portal and character of materials, as pertinent.)

13. Pumping Equipment:

(a) Pump CORNELL-CENTR. 2X3" Capacity 200 g.p.m.
(Make, type and size)


(b) Motor 3 PHASE 10-HP ELEC
(Type and horsepower)

14. Location of area irrigated or to be irrigated, or place of use if for purposes other than irrigation.

Township North or South	Range E. or W. of Willamette Meridian	Section	Forty-acre Tract	Number Acres To Be Irrigated	Date of Reclamation
9S	1W	19	SW/NE	6.0	1948

15. If the ground water supply is supplemental to an existing water supply, identification of any application for a permit, permit, certificate or adjudicated right to appropriate water made or held by the registrant.

Township 9S Range 1W, W.M.
North

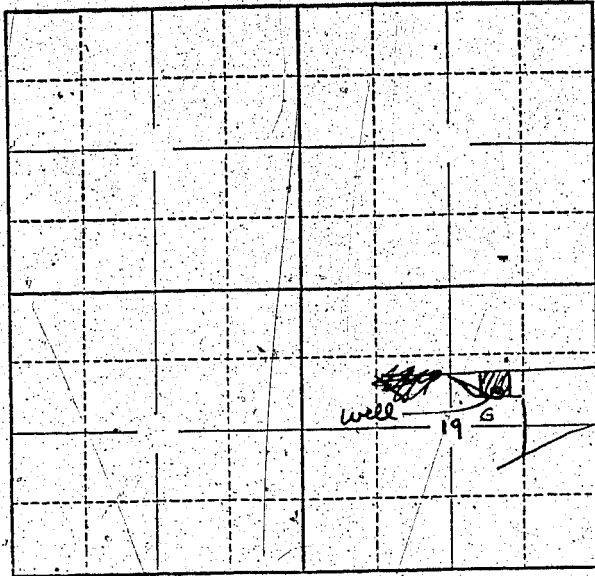

Locate well and acreage of irrigated land on plat.
Scale: 2" = 1 Mile

STATE OF OREGON

County of Marion } ss.

I, Evelyn E. Hatch, being first duly sworn, do hereby certify that I have read the foregoing Registration Statement and that all of the items therein contained are true to the best of my knowledge and belief.

Evelyn E. Hatch
(Signature of Registrant)

Subscribed and sworn to before me this 15 day of July, 1958.

My commission expires 8/21/58 Malta W. Bean
(Notary Public)

(SEAL)

CERTIFICATE OF REGISTRATION

STATE OF OREGON

County of Marion } ss.

This is to certify that the foregoing Registration Statement was received in the office of the State Engineer on the 16th day of July, 1958, at 2:00 o'clock A.M. and has been duly recorded in said office in Book No. 9 of Registration Statements on page GR-2090

Witness my hand this 16th day of February, 1959
Lewis A. Stanley
(State Engineer)

\$15.00

By _____
(Deputy)

GR - 2090