

Registration Statement

OF CLAIMANT OF RIGHT TO APPROPRIATE GROUND WATER

TO THE STATE ENGINEER OF OREGON:

I, ~~Mrs. W. H. Hatch~~ Evelyn E. Hatch
of Rt 1 Box 95 Aumsville County of Marion
(Mailing address)

State of ORE do hereby make application for a certificate of registration as evidence of a right to appropriate ground water.

1. Source from which water is withdrawn is Pump Well #1
(Flowing well, pump well, infiltration trench, or tunnel)

2. Location is: 4 1/2 mi S.W. STAYTON
(Approximate distance and direction from nearest city or town)

and is more particularly described as follows:

(a) 1254' W & 528' N from 1/4 Corner on E. Line Sec 19.
(Give distance and bearing to corner of section or other legal subdivision)

being within SE/NE of Sec. 19, Twp. 9S, Rge. 1W
(Smallest legal subdivision) (N. or S.) (E. or W.)

or (b) within limits of recorded platted property, town or city:

in Lot _____ Block _____ of _____
(Name of plat or addition)
County of _____
(If within city or town, give name)

3. Construction Work was begun on Apr. 1955; was completed on June 1956
(Date) (Date)

and the ground water claimed was first used for the purposes set out below on June 1956
(Date)

since which time the water has been used Interm.
(Continuously or intermittently)

from June 1956 to Sept 1957
(Date) (Date)

4. Quantity of water claimed and used is 200 gallons per minute; 37.5 acre feet per year.

5. Purpose or Purposes for which water is used Irrig.
(Domestic, irrigation, municipal, manufacturing, industrial, etc.)

6. Description of Well: Depth 12 feet Type Dug - Horizontal Well
8" - Vert shaft (Dug or drilled)

diameter 16" - Hor. inches. Elevation of ground at well site 275' feet, mean sea level.
(As near as known)

Depth to water table 2 feet.


7. Capacity of Well: 200 g.p.m. with 1 1/2 feet drawdown.
_____ g.p.m. with _____ feet drawdown.

Date of test During Irrig., 1957


If Flowing Well: Measured discharge _____ g.p.m. on _____
(Date)

Shut-in pressure at ground surface _____ lbs. per sq. in. on _____
(Date)

Water is controlled by _____
(Cap, valve, etc.)

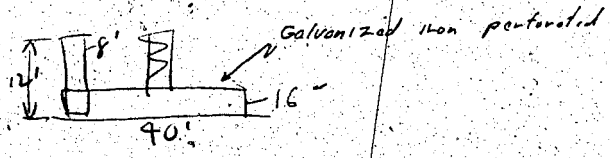

Township 25 Range 1W, W.M.
North

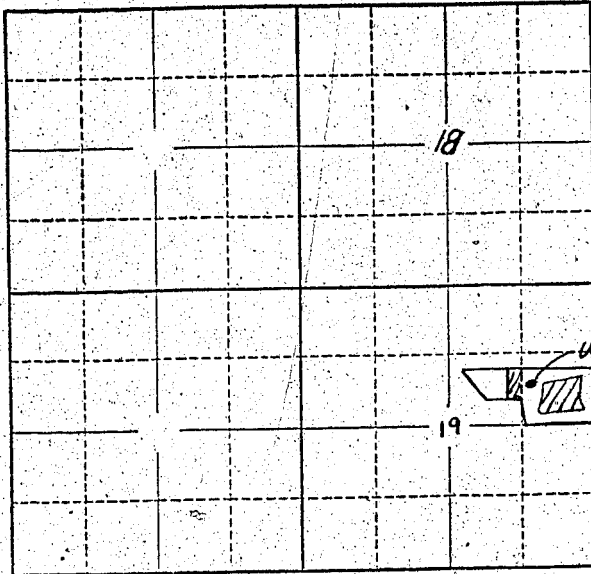

Locate well and acreage of irrigated land on plat.
Scale: 2" = 1 Mile

STATE OF OREGON

County of Marion } ss.

I, Evelyn E. Hatch, being first duly sworn, do hereby certify that I have read the foregoing Registration Statement and that all of the items therein contained are true to the best of my knowledge and belief.

Evelyn E. Hatch
(Signature of Registrant)

Subscribed and sworn to before me this 15 day of July, 1958.

My commission expires 8/21/58 Walter H. Jones
(Notary Public)

(SEAL)

CERTIFICATE OF REGISTRATION

STATE OF OREGON

County of Marion } ss.

This is to certify that the foregoing Registration Statement was received in the office of the State Engineer on the 16th day of July, 1958, at 2.00 o'clock A. M. and has been duly recorded in said office in Book No. 9 of Registration Statements on page GR-2091

Witness my hand this 16th day of February, 1959

Lawrence A. Stanley
(State Engineer)

By _____
(Deputy)

\$15.00

GR - 2091