

# Registration Statement

## OF CLAIMANT OF RIGHT TO APPROPRIATE GROUND WATER

TO THE STATE ENGINEER OF OREGON:

I, Frank J. Reichard  
of Rt 2 Box 32 Cornelius County of Washington  
(Mailing address)

State of Oregon do hereby make application for a certificate of registration as evidence of a right to appropriate ground water.

1. Source from which water is withdrawn is pump Well  
(Flowing well, pump well, infiltration trench, or tunnel)

2. Location is: 1 Mile West of Cornelius, Oregon  
(Approximate distance and direction from nearest city or town)

and is more particularly described as follows:

(a) Bag at NE Sec. 5 1740' Thence S. 700' to Well  
(Give distance and bearing to corner of section or other legal subdivision)

being within NW 1/4 NE 1/4 of Sec. 5, Twp. 15, Rge. 3W  
(Smallest legal subdivision) (N. or S.) (E. or W.)

or (b) within limits of recorded platted property, town or city:

in Lot \_\_\_\_\_, Block \_\_\_\_\_ of \_\_\_\_\_  
(Name of plat or addition)

County of Washington  
(If within city or town, give name)

3. Construction Work was begun on 1900; was completed on 1900  
(Date) (Date)

and the ground water claimed was first used for the purposes set out below on 1949  
(Date)

since which time the water has been used Continuously  
(Continuously or intermittently)

from 1949 to 1958  
(Date) (Date)

4. Quantity of water claimed and used is 15 gallons per minute; \_\_\_\_\_ acre feet per year.

5. Purpose or Purposes for which water is used irrigation

6. Description of Well: Depth 40 feet. Type drilled  
(Domestic, irrigation, municipal, manufacturing, industrial, etc.) (Dug or drilled)

diameter 4 inches. Elevation of ground at well site 200 feet, mean sea level.  
(As near as known)

Depth to water-table 18 feet.

7. Capacity of Well: 15 g.p.m. with 18 feet drawdown.  
\_\_\_\_\_ g.p.m. with \_\_\_\_\_ feet drawdown.

Date of test No test

If Flowing Well: Measured discharge \_\_\_\_\_ g.p.m. on \_\_\_\_\_  
(Date)


Shut-in pressure at ground surface \_\_\_\_\_ lbs. per sq. in. on \_\_\_\_\_  
(Date)

Water is controlled by \_\_\_\_\_  
(Cap, valve, etc.)





Township 15 Range 3W, W.M.  
North

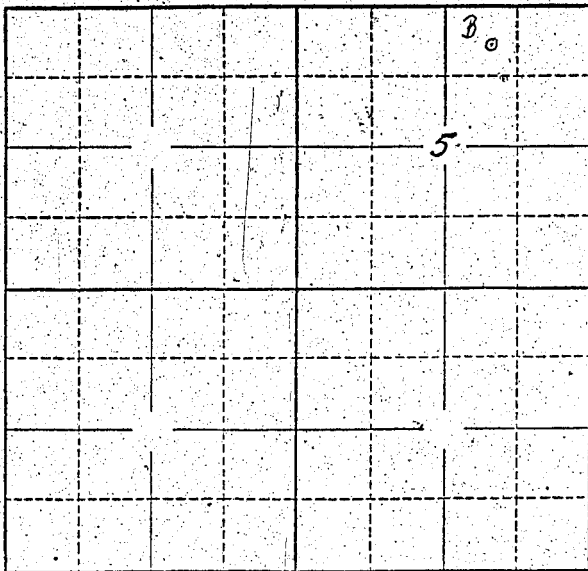

Locate well and acreage of irrigated land on plat.  
Scale: 2" = 1 Mile

STATE OF OREGON

County of Marion } ss.

I, Frank J. Reichard, being first duly sworn, do hereby certify that I have read the foregoing Registration Statement and that all of the items therein contained are true to the best of my knowledge and belief.

Frank J. Reichard  
(Signature of Registrant)

Subscribed and sworn to before me this 7th day of July, 1958

My commission expires 12th June 1961 Wm. S. Bartholomew  
(Notary Public)

(SEAL)

**CERTIFICATE OF REGISTRATION**

STATE OF OREGON

County of Marion } ss.

This is to certify that the foregoing Registration Statement was received in the office of the State Engineer on the 16th day of July, 1958, at 2.00 o'clock A. M. and has been duly recorded in said office in Book No. 9 of Registration Statements on page GR-2093

Witness my hand this 16th day of February, 1959

Lewis A. Stanley  
(State Engineer)

\$1500

By \_\_\_\_\_  
(Deputy)