

Registration Statement

OF CLAIMANT OF RIGHT TO APPROPRIATE GROUND WATER

TO THE STATE ENGINEER OF OREGON:

I, Earl A. & Marian J. Keeney
of 3245 NE 73 Portland Oregon County of Multnomah
(Mailing address)

State of Oregon do hereby make application for a certificate of registration as evidence of a right to appropriate ground water.

1. Source from which water is withdrawn is Pump Well
(Flowing well, pump well, infiltration trench, or tunnel)

2. Location is: About one mile North East of Hershman, Oregon
(Approximate distance and direction from nearest city or town)

and is more particularly described as follows:

(a) 740 feet south & 480 feet east from NW corner Section 2
(Give distance and bearing to corner of section or other legal subdivision)

being within NW 1/4 of NW 1/4 of Sec. 2, Twp. 1 S Rge. 3 E
(Smallest legal subdivision) (N. or S.) (E. or W.)

or (b) within limits of recorded platted property, town or city:

in Lot 6, Block - of Hall Park
(Name of plat or addition)
County of Multnomah
(If within city or town, give name)

3. Construction Work was begun on March 25, 1951, was completed on March 31, 1951
(Date) (Date)

and the ground water claimed was first used for the purposes set out below on April 2, 1951
(Date)

since which time the water has been used Intermittently
(Continuously or intermittently)

from April 2, 1951 to date
(Date) (Date)

4. Quantity of water claimed and used is 15 gallons per minute; _____ acre feet per year.

5. Purpose or Purposes for which water is used Irrigation, domestic, & other
(Domestic, irrigation, municipal, manufacturing, industrial, etc.)

6. Description of Well: Depth 59 feet. Type Drilled
(Dug or drilled)

diameter 18 inches. Elevation of ground at well site 350 feet, mean sea level.
(As near as known)

Depth to water table 4.5 feet.

7. Capacity of Well: 15 g.p.m. with 5 feet drawdown. 7200 gallons per hour
20 g.p.m. with _____ feet drawdown.

Date of test March 31, 1951

If Flowing Well: Measured discharge _____ g.p.m. on _____ (Date)

Shut-in pressure at ground surface _____ lbs. per sq. in. on _____ (Date)

Water is controlled by _____
(Cap, valve, etc.)

8. Casing: (Give diameter, commercial specifications and depth below ground surface of each casing size.)

6 inch diameter *Iron* from *Surface* to *58* feet
 inch diameter *Iron* from to feet
 inch diameter from to feet
 inch diameter from to feet

Describe and show depth of shoe, plug, adapter, liner or other details: *58 feet*
iron casing welded

9. Perforated Casings or Screens:

none from to
 (Number per foot and size of perforations, or describe screen)
 from to
 from to
 from to

10. Log of Well: (Describe each stratum or formation clearly, indicate if water bearing, and give thickness and depth as indicated.)

MATERIAL	Thickness (Feet)	Depth to Bottom (Feet)
<i>Sand no water</i>	<i>9 feet</i>	<i>9 feet</i>
<i>Sand & gravel no water</i>	<i>4.5 feet</i>	<i>13.5 feet</i>
<i>Red rock no hard water</i>	<i>5 feet</i>	<i>18.5 feet</i>
<i>Water under pressure</i>		

If log of well is not available, give name and address of driller. Hansblat & Johnson
Dullin Co. 5320 SE Woodstock Portland Oregon

11. Infiltration Trench: Covered or open _____
 Dimensions: Length _____ ft. Minimum depth _____ ft. Maximum depth _____ ft.
 Bottom width _____ ft. Discharge _____ g.p.m. Date of test _____

12. Tunnel: Type of lining _____
 Dimensions: _____
(Length, course, and cross sectional size)
 Position of water bearing stratum with reference to portal of tunnel _____

Log of tunnel: (Preceding table for log of well may be used, if desired. Give footage from portal and character of materials, as pertinent.)

13. Pumping Equipment:
 (a) Pump Piston type Capacity ~~100~~ 15 g.p.m.
(Make, type and size)
 (b) Motor 1/2 horsepower Electric
(Type and horsepower)


14. Location of area irrigated or to be irrigated, or place of use if for purposes other than irrigation.

Township North or South	Range E. or W. of Willamette Meridian	Section	Forty-acre Tract	Number Acres To Be Irrigated	Date of Reclamation
15	3 E	28	NW 1/4 of NW 1/4	4.2 +	1951

15. If the ground water supply is supplemental to an existing water supply, identification of any application for a permit, permit, certificate or adjudicated right to appropriate water made or held by the registrant.
None

Township 1.5 Range 3 E W.M.

Stark Street North

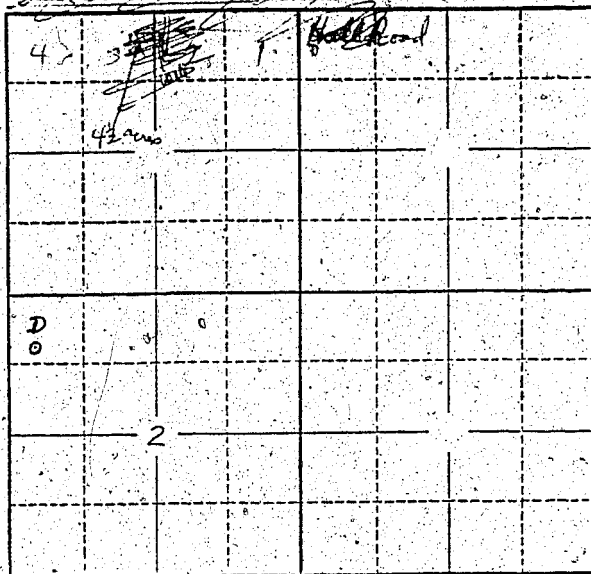

Well in SE corner of 4 1/2 acre tract

Locate well and acreage of irrigated land on plat.

Scale: 2" = 1 Mile

STATE OF OREGON

County of Washington } ss.

I, Earl A. Keeney & Marjorie J. Keeney being first duly sworn, do hereby certify that I have read the foregoing Registration Statement and that all of the items therein contained are true to the best of my knowledge and belief.

Earl A. Keeney Marjorie J. Keeney
(Signature of Registrant)

Subscribed and sworn to before me this 15th day of July, 1958

My commission expires 3-7-62
W. H. Jones
(Notary Public)

(SEAL)

CERTIFICATE OF REGISTRATION

STATE OF OREGON } ss.
County of Marion

This is to certify that the foregoing Registration Statement was received in the office of the State Engineer on the 16th day of July, 1958, at 8:00 o'clock A.M. and has been duly recorded in said office in Book No. 9 of Registration Statements on page GR-2096

Witness my hand this 16th day of February, 1959

Lewis A. Stanley
(State Engineer)

By _____
(Deputy)

\$15.00