

Registration Statement

OF CLAIMANT OF RIGHT TO APPROPRIATE GROUND WATER

TO THE STATE ENGINEER OF OREGON:

I, FRANK T. WILCOX

of NEWBERG, OREGON County of YAMHILL
(Mailing address)

State of OREGON, do hereby make application for a certificate of registration as evidence of a right to appropriate ground water.

1. Source from which water is withdrawn is PUMP WELL
(Flowing well, pump well, infiltration trench, or tunnel)

2. Location is: 3 miles N. E. of St. Paul, Oregon
(Approximate distance and direction from nearest city or town)

and is more particularly described as follows:

(a) 1025 ft. N. E. 1370 ft. W. from S. E. Corner Section 10
(Give distance and bearing to corner of section or other legal subdivision)
being within S. W. 1/4 of S. E. 1/4 of Sec. 10, Twp. 4 S., Rge. 2 E.
(Smallest legal subdivision) (N. or S.) (E. or W.)

or (b) within limits of recorded platted property, town or city:

in Lot _____, Block _____ of _____
(Name of plat or addition)
County of _____
(If within city or town, give name)

3. Construction Work was begun on 1947; was completed on 1947
(Date) (Date)

and the ground water claimed was first used for the purposes set out below on 1947
(Date)

since which time the water has been used during season, intermittently
(Continuously or intermittently)
from 1947 to October 1957
(Date) (Date)

4. Quantity of water claimed and used is 700 gallons per minute; _____ acre feet per year.

5. Purpose or Purposes for which water is used for irrigation

(Domestic, irrigation, municipal, manufacturing, industrial, etc.)

6. Description of Well: Depth 110 feet. Type Drilled
(Dug or drilled)

diameter 10 inches. Elevation of ground at well site _____ feet, mean sea level.
(As near as known)

Depth to water table 35 feet.

7. Capacity of Well: 1000 g.p.m. with 770 feet drawdown.
_____ g.p.m. with _____ feet drawdown.

Date of test 1947

If Flowing Well: Measured discharge _____ g.p.m. on _____
(Date)

Shut-in pressure at ground surface _____ lbs. per sq. in. on _____
(Date)

Water is controlled by _____
(Cap, valve, etc.)

8. Casing: (Give diameter, commercial specifications and depth below ground surface of each casing size.)

10 inch diameter from top to 110 feet

..... inch diameter from to feet

..... inch diameter from to feet

..... inch diameter from to feet

Describe and show depth of shoe, plug, adapter, liner or other details: This pump has 100 ft 6"

10 Column x 1-1/8 shaft --- 5 stage 10LC Bowl assembly --- 10 ft suction pipe

H/E Discharge head --- 30 HP 1800 RPM 3 phase 60 cycle 220 volt vertical hollow shaft motor --- Pump conditions; 160 GPM 200 Ft TDH. This was installed April 5, 1947. I assume the well must be about 110 ft deep.

9. Perforated Casings or Screens:

..... from to
(Number per foot and size of perforations, or describe screen)

..... from to

..... from to

..... from to

10. Log of Well: (Describe each stratum or formation clearly, indicate if water bearing, and give thickness and depth as indicated.)

MATERIAL	Thickness (Feet)	Depth to Bottom (Feet)

If log of well is not available, give name and address of driller.

11. Infiltration Trench: Covered or open

Dimensions: Length ft. Minimum depth ft. Maximum depth ft.

Bottom width ft. Discharge g.p.m. Date of test

12. Tunnel: Type of lining

Dimensions: (Length, course, and cross sectional size)

Position of water bearing stratum with reference to portal of tunnel

Log of tunnel: (Preceding table for log of well may be used, if desired. Give footage from portal and character of materials, as pertinent.)

13. Pumping Equipment:

(a) Pump TURBINE Capacity 700 g.p.m.


(b) Motor 30HPM 70-18961511

14. Location of area irrigated or to be irrigated, or place of use if for purposes other than irrigation.

Table with 6 columns: Township North or South, Range E. or W. of Willamette Meridian, Section, Forty-acre Tract, Number Acres To Be Irrigated, Date of Reclamation. Contains handwritten entries for T4S, R2E, Section 10, and tracts NE 1/4 and SE 1/4 of S.E. 1/4.

15. If the ground water supply is supplemental to an existing water supply, identification of any application for a permit, permit, certificate or adjudicated right to appropriate water made or held by the registrant.

Township 4S Range 2E W.M.
North

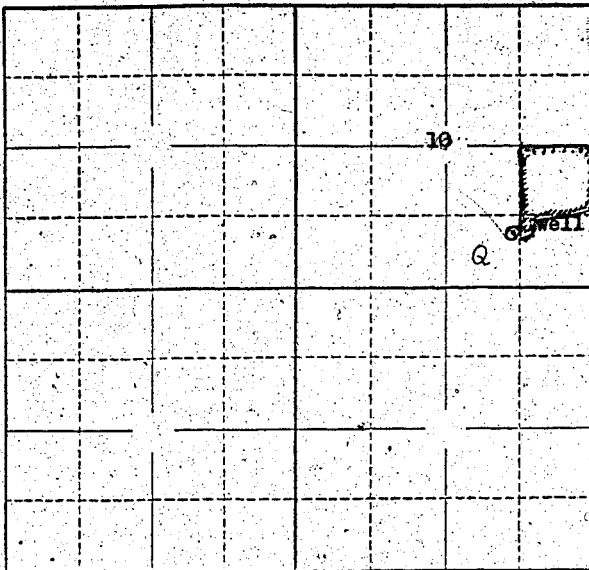

Locate well and acreage of irrigated land on plat.
Scale: 2" = 1 Mile

STATE OF OREGON

County of YAMHILL } ss.

I, FRANK T. WILCOX, being first duly sworn, do hereby certify that I have read the foregoing Registration Statement and that all of the items therein contained are true to the best of my knowledge and belief.

Frank T. Wilcox
(Signature of Registrant)

Subscribed and sworn to before me this 25 day of February, 1959.

My commission expires 12-1-60

(Notary Public)

(SEAL)

CERTIFICATE OF REGISTRATION

STATE OF OREGON

County of Marion } ss.

This is to certify that the foregoing Registration Statement was received in the office of the State Engineer on the 16th day of July, 1958, at 8:00 o'clock A. M. and has been duly recorded in said office in Book No. 9 of Registration Statements on page GR-2099

Witness my hand this 16th day of February, 1959.

Claris A. Stanley
(State Engineer)

By _____ (Deputy)

\$18.00