

Registration Statement**OF CLAIMANT OF RIGHT TO APPROPRIATE GROUND WATER****TO THE STATE ENGINEER OF OREGON:**

I, Oregon State Highway Commission (State Parks Division)
 of 301 State Highway Building, Salem County of Marion
(Mailing address)

State of Oregon, do hereby make application for a certificate of registration as evidence of a right to appropriate ground water.

1. Source from which water is withdrawn is Pump Well
(Flowing well, pump well, infiltration trench, or tunnel)

2. Location is: 3 Miles West of Meacham on old Oregon Trail Highway
(Approximate distance and direction from nearest city or town)

and is more particularly described as follows:

(a) Approximately 1,150 Ft. South and 125 Ft. East of N $\frac{1}{2}$ Corner of Sec. 29
(Give distance and bearing to corner of section or other legal subdivision)
 being within NW $\frac{1}{4}$ of NE $\frac{1}{4}$ of Sec. 29, Twp. 1 N., Rge. 35 E., W. 1 N.
(Smallest legal subdivision) (N. or S.) (E. or W.)

or (b) within limits of recorded platted property, town or city:

in Lot _____, Block _____ of _____
(Name of plat or addition)

(If within city or town, give name) County of _____

3. Construction Work was begun on 1934 (?); was completed on 1934 (?)
(Date) (Date)

and the ground water claimed was first used for the purposes set out below on 1934 (?)
(Date)

since which time the water has been used Continuously
(Continuously or intermittently)

from 1934 (?) to Date _____
(Date) (Date)

4. Quantity of water claimed and used is 28 gallons per minute; _____ acre feet per year.

5. Purpose or Purposes for which water is used Public Park Purposes

(Migrant Springs State Park)
(Domestic, irrigation, municipal, manufacturing, industrial, etc.)

6. Description of Well: Depth 377 feet. Type Drilled
(Dug or drilled)

diameter 6 inches. Elevation of ground at well site 3674 feet, mean sea level.
(As near as known)

Depth to water table 75 feet.

7. Capacity of Well: 28 g.p.m. with 229 feet drawdown.

55 g.p.m. with 275 feet drawdown.


Date of test 12/2/1954

If Flowing Well: Measured discharge _____ g.p.m. on _____
(Date)

Shut-in pressure at ground surface _____ lbs. per sq. in. on _____
(Date)

Water is controlled by _____
(Csp, valve, etc.)

Township 1 N. Range 35 E., W.M.
North

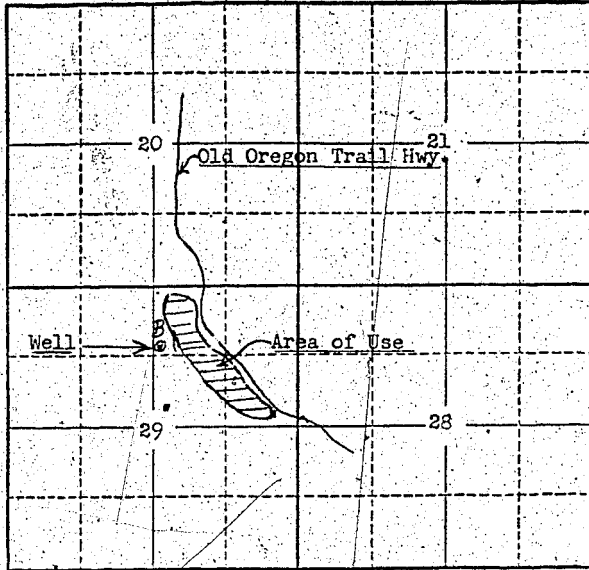

Locate well and acreage of irrigated land on plat
Scale: 2" = 1 Mile

STATE OF OREGON

County of Marion } ss.

I, C. H. Armstrong, being first duly sworn, do hereby certify that I have read the foregoing Registration Statement and that all of the items therein contained are true to the best of my knowledge and belief.

C. H. Armstrong
(Signature of Registrant)
State Parks Superintendent

Subscribed and sworn to before me this 14 day of July, 1958

My commission expires Nov-7-1959

(Notary Public)

(SEAL)

CERTIFICATE OF REGISTRATION

STATE OF OREGON

County of Marion } ss.

This is to certify that the foregoing Registration Statement was received in the office of the State Engineer on the 16th day of July, 1958, at 9:00 o'clock A.M. and has been duly recorded in said office in Book No. 9 of Registration Statements on page GR 2100

Witness my hand this 16th day of February, 1959

Henry A. Stanley
(State Engineer)

By _____ (Deputy)

GR - 2100

\$ 20.00